



1 2 3 4 5 6 7 8 9 10 11 12 13 14


M  
L  
K  
J  
H  
G  
F  
E  
D  
C  
B  
A

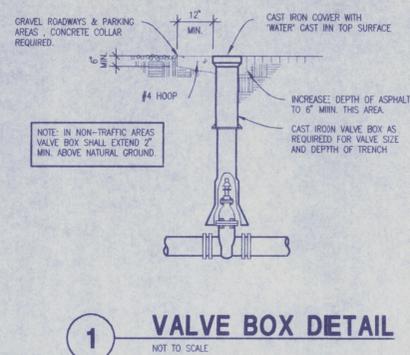


**1 VALVE BOX DETAIL**  
NOT TO SCALE

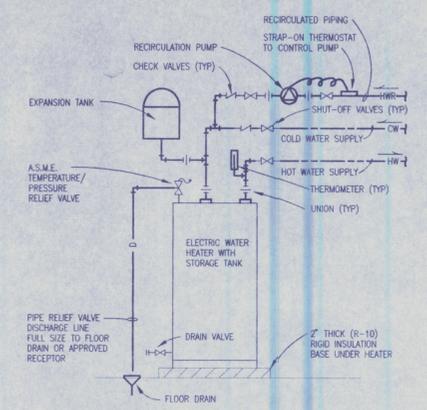

**4 WATER HEATER DETAIL**  
NOT TO SCALE ELECTRIC W/ RECIRCULATION

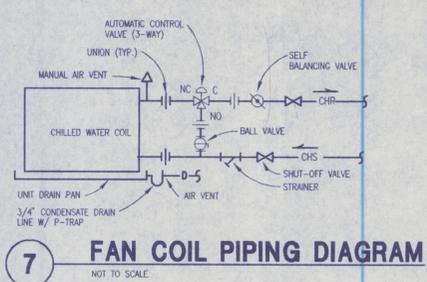


**7 FAN COIL PIPING DIAGRAM**  
NOT TO SCALE

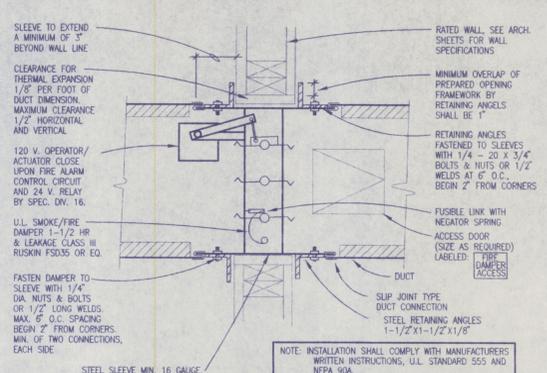


**11 FIRESMOKE DAMPER**  
NOT TO SCALE


Sheet M5.1 DETAILS:  
1. CONDENSATE DRAIN DETAIL No. 5: Provide open hub drain sizes as indicated on the plans. Provide access door to open hub drains where concealed.

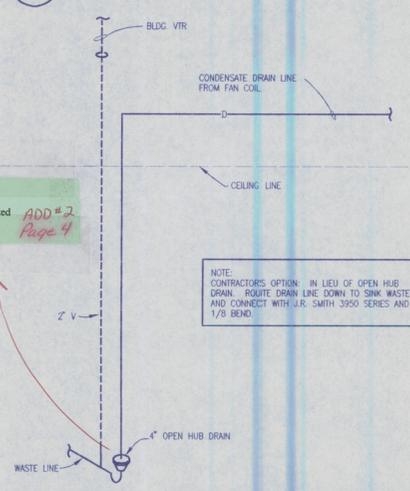


**5 CONDENSATE DRAIN DETAIL**  
NOT TO SCALE

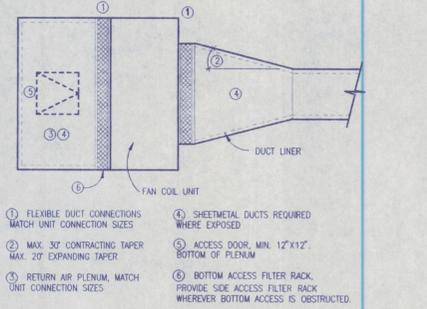

**8 FAN COIL UNIT DUCT**  
NOT TO SCALE

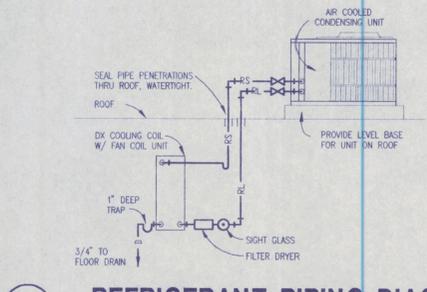


**9 REFRIGERANT PIPING DIAGRAM**  
NOT TO SCALE

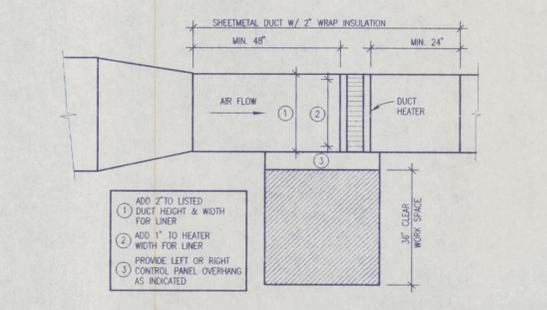


**12 ELECTRIC DUCT HEATER DETAIL**  
NOT TO SCALE


**2 NOT USED**  
NOT TO SCALE

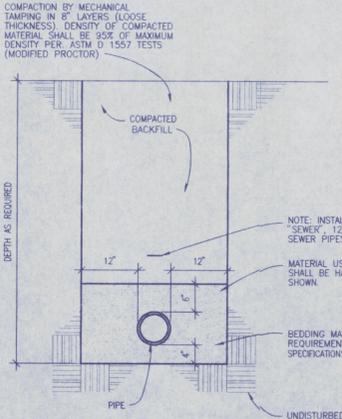


**3 TYPICAL PIPE TRENCH SECTION**  
NOT TO SCALE

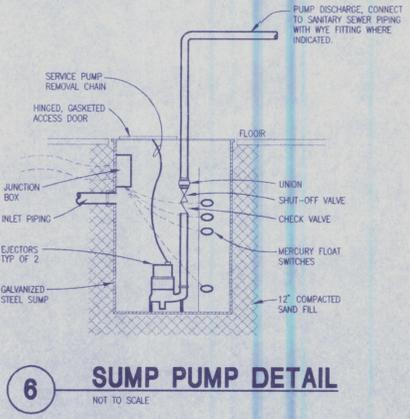


**6 SUMP PUMP DETAIL**  
NOT TO SCALE

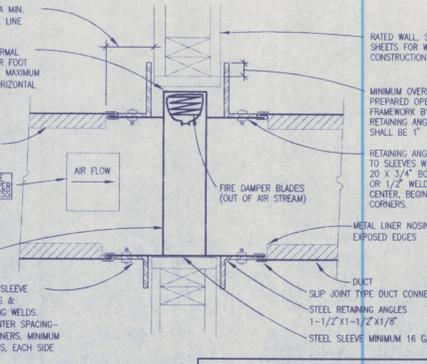

**10 WALL FIRE DAMPER DETAIL**  
NOT TO SCALE

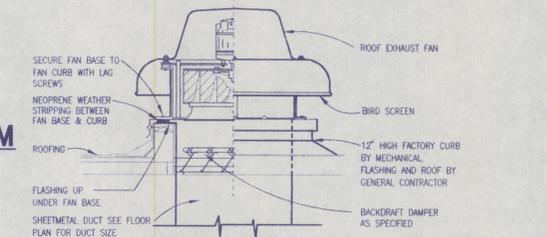

**13 EXHAUST FAN DETAIL**  
NOT TO SCALE

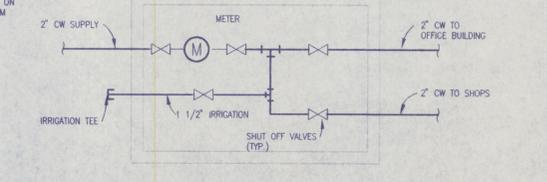

**14 METER VAULT DETAIL**  
NOT TO SCALE

**AS-BUILT**

No.	REVISIONS/SUBMISSIONS	DATE

**ZB La** ZeckButler Architects PS

The Proben Center Suite 800 West 421 Riverside, Spokane WA 99201 (509) 456-8238/Fax (509) 747-0570  
The Edwards Building 1029 West Broadway, Moses Lake WA 98857 (509) 765-9825/Fax (509) 765-0797

PROJECT TITLE  
**GRANT COUNTY PUBLIC WORKS OFFICE/SHOP COMPLEX**  
EPRHATA, WA

SHEET TITLE  
DETAILS

DATE	3/8/96	PROJECT NO.	4575 (45219)
DRAWN	DRD	DRAWING NO.	
CHECKED	D&R		
REVIEWED	DWS		

**M5.1**

J. GRANT-CO-UP212RWINGUETS REG. NO. 13 17-02-11-1996