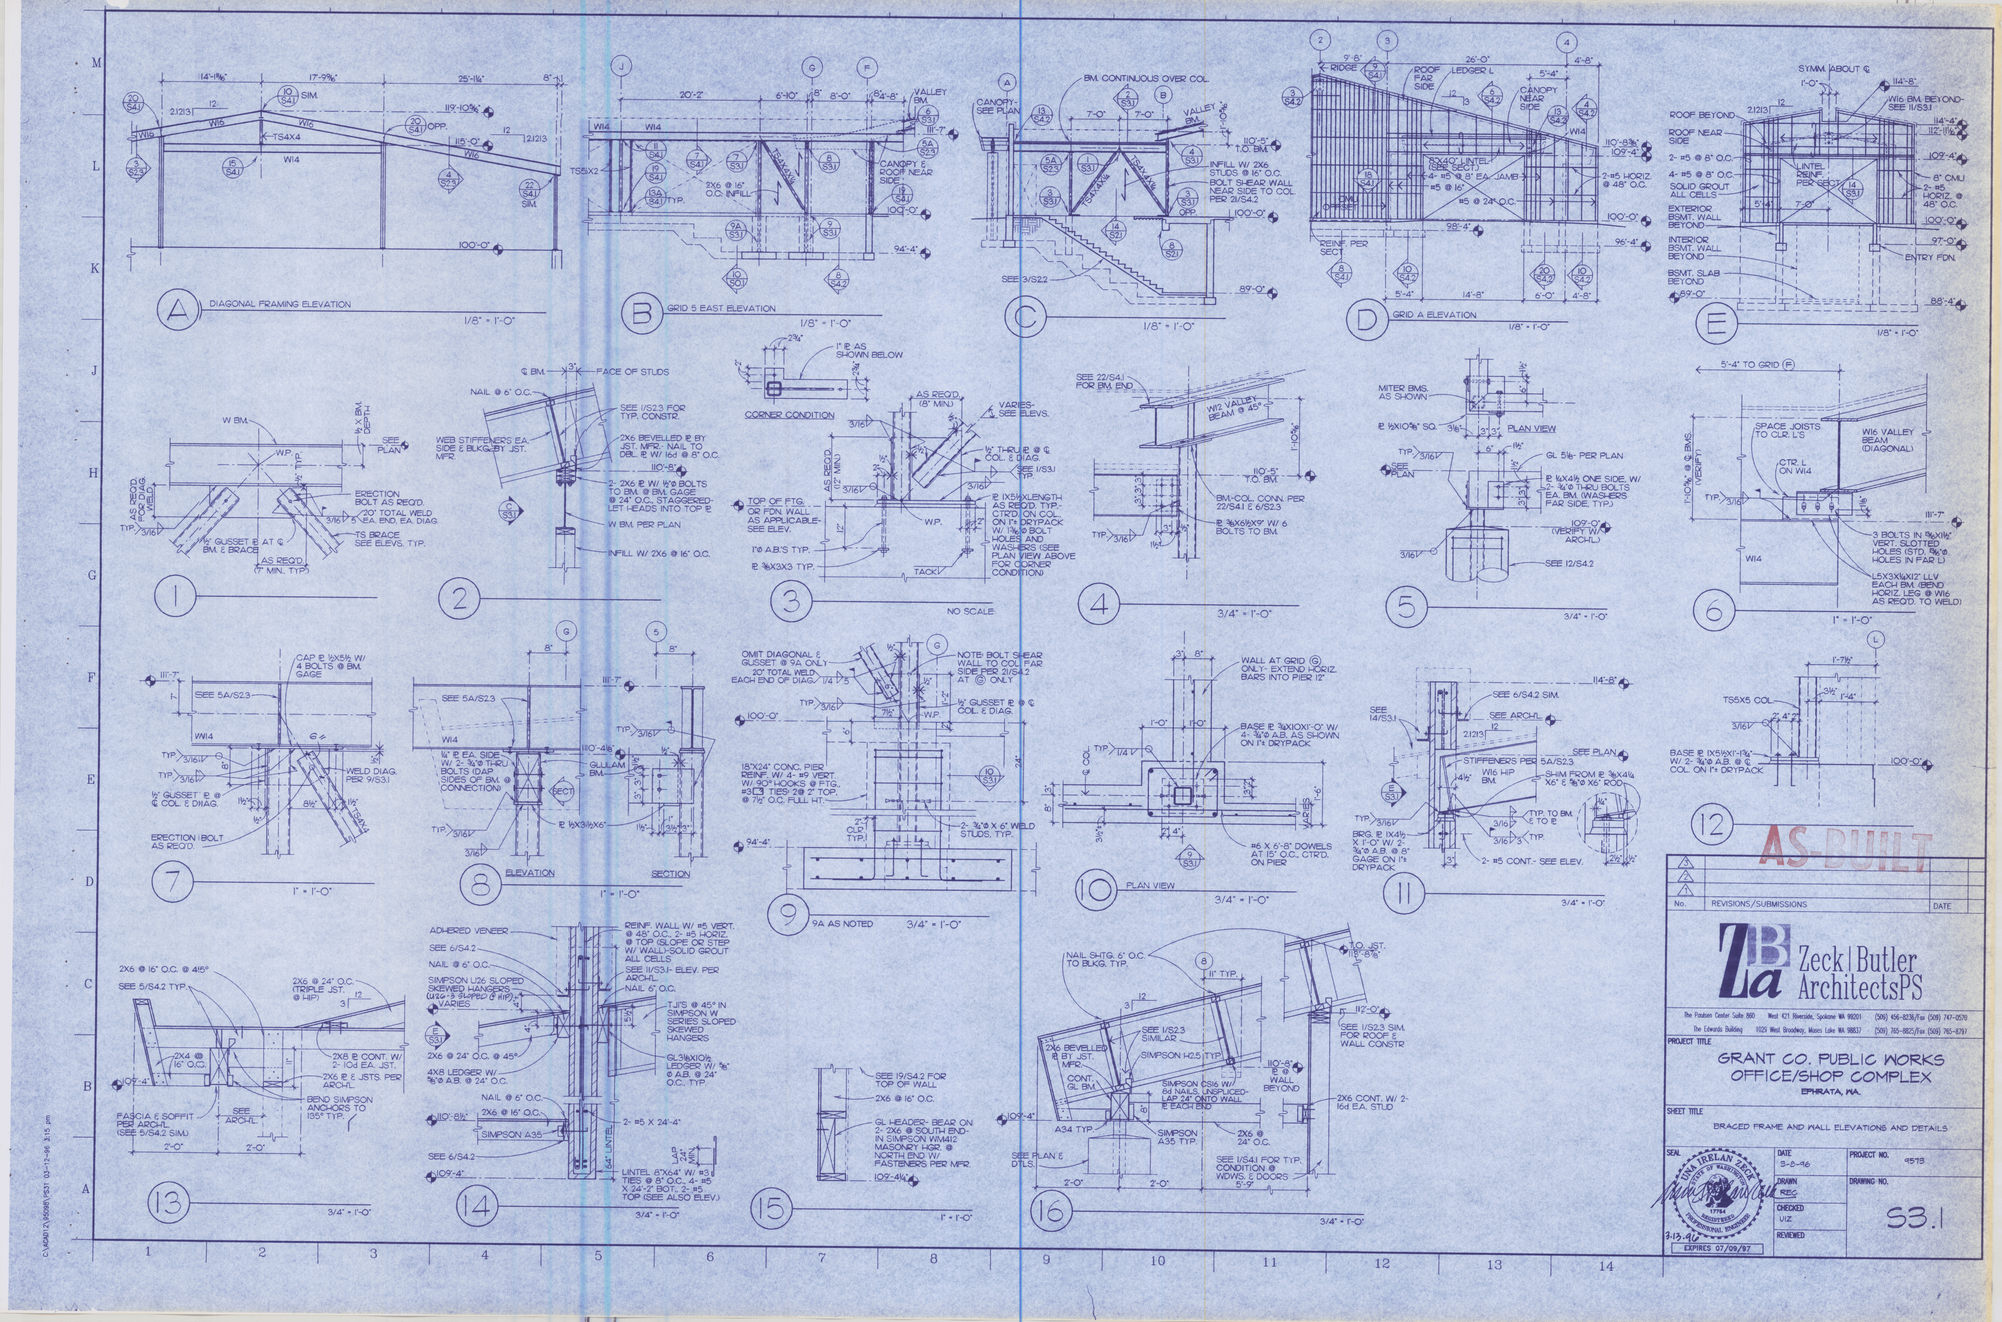
A DIAGONAL FRAMING ELEVATION 1/8" = 1'-0"
B GRID 5 EAST ELEVATION 1/8" = 1'-0"
C 1/8" = 1'-0"
D GRID A ELEVATION 1/8" = 1'-0"
E 1/8" = 1'-0"
1
2
3 NO SCALE
4 3/4" = 1'-0"
5 3/4" = 1'-0"
6 1" = 1'-0"
7 1" = 1'-0"
8 ELEVATION SECTION 1" = 1'-0"
9 9A AS NOTED 3/4" = 1'-0"
10 PLAN VIEW 3/4" = 1'-0"
11 3/4" = 1'-0"
12
13 3/4" = 1'-0"
14 3/4" = 1'-0"
15 1" = 1'-0"
16 3/4" = 1'-0"
AS-BUILT
No. REVISIONS/SUBMISSIONS DATE
Zeck | Butler ArchitectsPS
The Pavilion Center Suite 800 West 421 Riverside, Spokane WA 99201 (509) 456-8238/Fax (509) 747-0570
The Edwards Building 1525 West Broadway, Moses Lake WA 98837 (509) 765-8821/Fax (509) 765-6761
PROJECT TITLE
GRANT CO. PUBLIC WORKS OFFICE/SHOP COMPLEX
EPHRATA, WA.
SHEET TITLE
BRACED FRAME AND WALL ELEVATIONS AND DETAILS
SEAL
DATE 3-8-96
PROJECT NO. 4513
DRAWN REC
CHECKED UIZ
REVIEWED
DRAWING NO. S3.1
EXPIRES 07/09/97