SYMBOLS LIST:

(3)	NOTE REFERENCE
102	ROOM NUMBER
	FLUORESCENT FIXTURE
	INCANDESCENT OR H.I.D. FIXTURE
	EXIT FIXTURE
	EXTERIOR POLE FIXTURE
	SINGLE POLE SWITCH
	THREE-WAY SWITCH - MOUNTED UP 48"
	FOUR-WAY SWITCH - MOUNTED UP 48"
	DUPLEX RECEPTACLE - MOUNTED UP 16"
	DOUBLE DUPLEX RECEPTACLE - MOUNTED UP 16"
	SPECIAL RECEPTACLE - MOUNTED UP 16"
	GROUND FAULT INTERRUPTING RECEPTACLE - MOUNTED UP 16"
	MULTI-OUTLET ASSEMBLY
	FLOOR BOX
	JUNCTION BOX
	MOTOR CONNECTION
	DISCONNECT SWITCH
	PANELBOARD
	CONCEALED CONDUIT
	CROSSHATCH DENOTES WIRES NO CROSSHATCH DENOTES 2 WIRES - #12AWG MINIMUM
	EXPOSED CONDUIT
	TELEPHONE OUTLET - MOUNTED UP 16"
C	COMPUTER OUTLET - MOUNTED UP 16" 2 INDICATES 2 RJ-45 JACKS AT ON LOCATION.
I	INTERCOM SPEAKER
I H	INTERCOM HORN
	FIRE ALARM MINI SIGNAL
F	FIRE ALARM MANUAL STATION - MOUNTED UP 48"
H	HEAT DETECTOR
S	SMOKE DETECTOR
S	DUCT MOUNTED SMOKE DETECTOR
M	MAGNETIC HOLD OPEN DEVICE
D	CONNECTION TO ELECTRIC DOOR CLOSER
R	FAN SHUTDOWN RELAY
R	RELAY
WP	WEATHERPROOF
A	DENOTES TO MOUNT DEVICE 2" ABOVE COUNTERTOP/BACKSPLASH
R	4 SQUARE BOX, SINGLE GANG MUD RING WITH CONDUIT STUB ABOVE CEILING. FOR RADIO CONNECTION. LEAVE PULL STRING AND BLANK PLATE.
R	SPEAKER FOR RADIO SYSTEM. CONDUIT WITH SPEAKER WIRE TO BASE STATION

ADD #1 Page 9

11. Sheet E-1:
1. Two Type 14 fixtures referenced by Keyed Note 1 to be Type 15 fixtures.

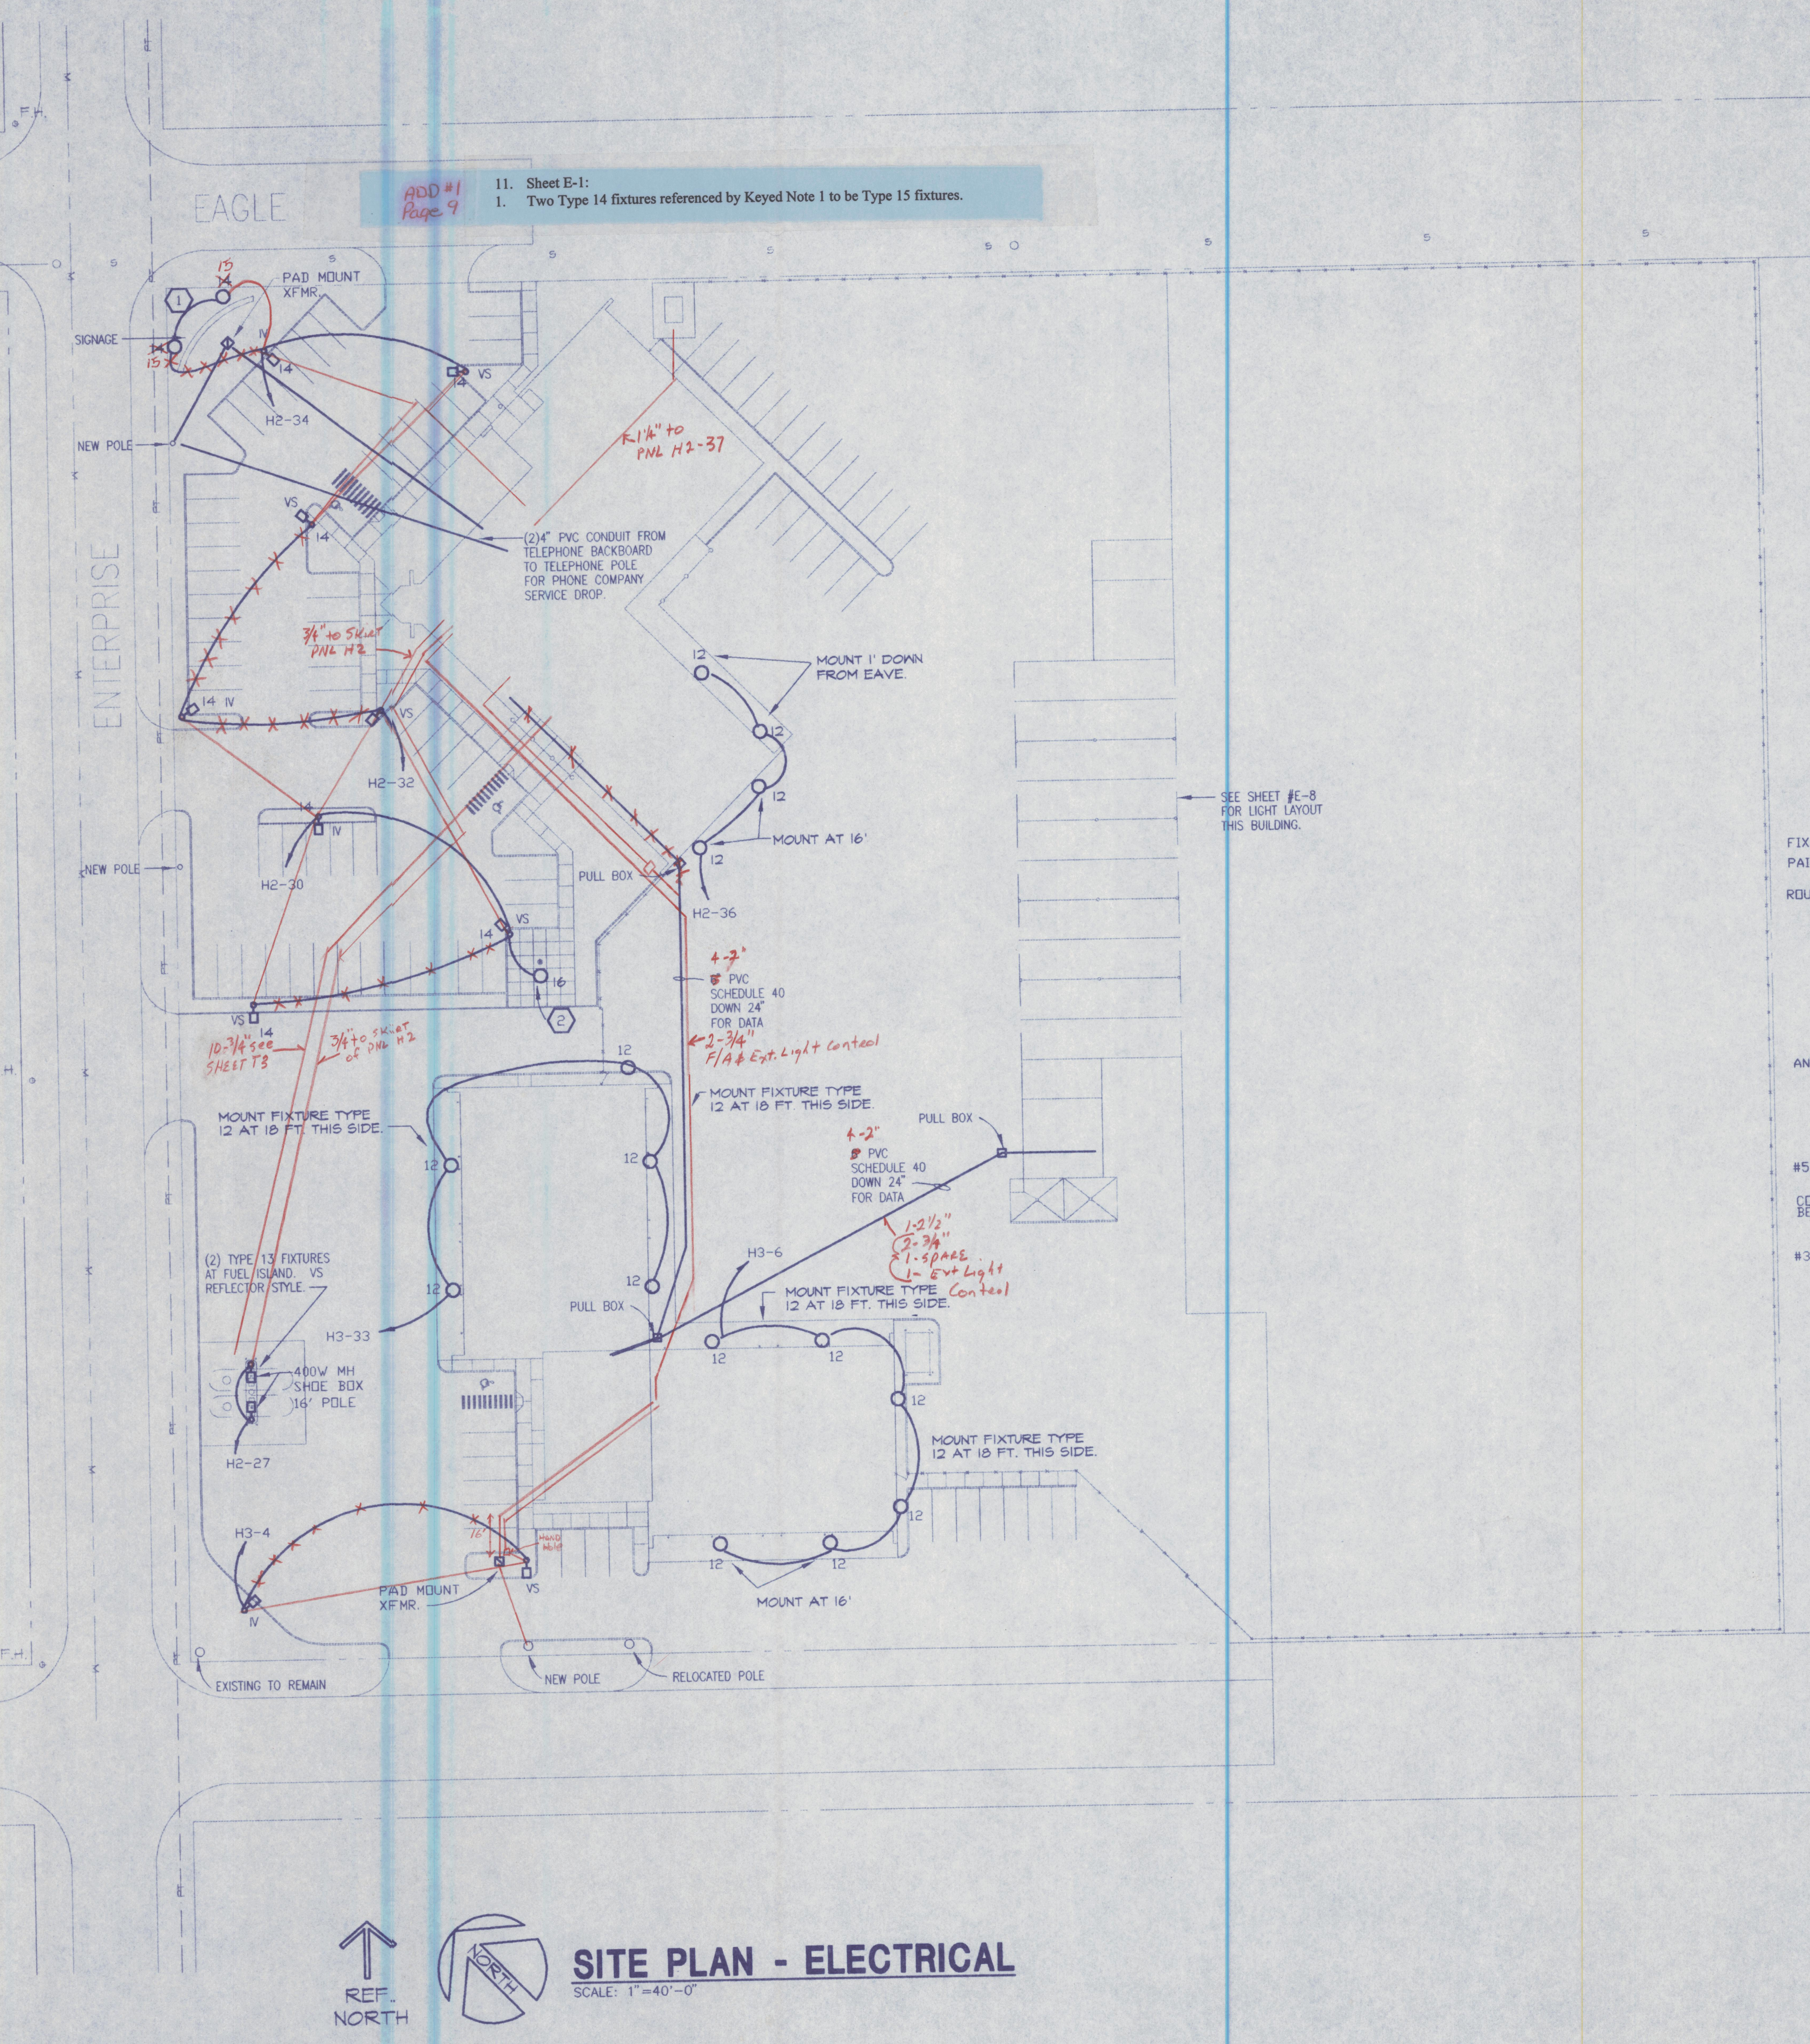

SITE PLAN - ELECTRICAL

SCALE: 1"=40'-0"

KEYED NOTES:

(1) TYPE 15 FIXTURE TO BE INSTALLED APPROXIAMATELY 7 FT. IN FROM END OF WALL AND APPROXIMATELY 4 FT. OUT FROM WALL. FIELD ADJUST TO MAXIMISE LIGHT ON SIGNAGE.

(2) TYPE 16 FIXTURE TO BE INSTALLED APPROXIAMATELY 6 FT. OUT FROM POLE. FIELD ADJUST FOR MAXIMUM LIGHT ON FLAG. MOUNT FIXTURES OPPOSITE ONE ANOTHER.

NOTES:

1. IV NOTATION BY TYPE 14 FIXTURES DENOTES FORWARD THROW REFLECTOR. VS DENOTES SYMETRIC SQUARE. REFLECTOR.

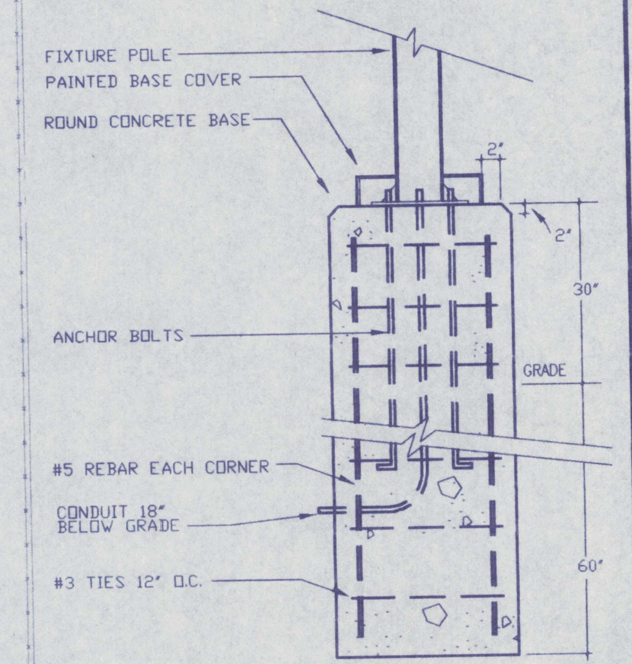

POLE BASE DETAIL

NTS

FIXTURE SCHEDULE

1. COLUMBIA #P4-2436-43363-1-277V-EOB
   (3)FO32T8 LAMPS 97W
   RECESSED MOUNTED
2. COLUMBIA #4PS6G-84-242-277V-EOB
   (2)FO32T8 LAMPS 67W
   RECESSED MOUNTED
3. COLUMBIA #4PS6G-84-243-277V-EOB
   (3)FO32T8 LAMPS 97W
   RECESSED MOUNTED
4. PRESCOLITE #CFR818-492-SLR8-ELEC BAL
   (2)18W QUAD TWIN TUBE 54W
   RECESSED MOUNTED
5. COLUMBIA #WC 240-A-277V-EOB
   (2)FO32T8 LAMPS 67W
   SURFACE MOUNTED
6. COLUMBIA #CS140-277V-EOB
   (1)FO32T8 LAMPS 39W
   COVE MOUNTED
7. COLUMBIA #CS240-277V-EOB-CA48
   (2)FO32T8 LAMPS 67W
   COVE MOUNTED
8. COLUMBIA #KL2-96HO-277V-CE2-LG2
   (2)96T12HO LAMPS 67W
   SURFACE MOUNTED
9. COLUMBIA #KL240-277V-CE2-LG2-EOB
   (2)FO32T8 LAMPS 67W
   SURFACE MOUNTED
10. PRESCOLITE #TL30-277V-ELEC BALLAST
    (1)13W QUAD 18W
    RECESS MOUNTED
11. PRESCOLITE #91M5-100MHFE-F71
    (1)70W MH 95W
    RECESS MOUNTED
12. GE #WILR 15 M 4 M L DB
    (1)150W MH 204W
    SURFACE MOUNTED
13. SPAULDING #CEI PM M400 VS 277
    (1)400W MH 480W
    POLE MOUNDTED 16 FT.
    COLOR TO BE SELECTED BY ARCHITECT FROM STANDARD COLORS.
14. SPAULDING #CEII PM M400 VS 277
    (1)400W MH 480W
    POLE MOUNDTED 25 FT.
    COLOR TO BE SELECTED BY ARCHITECT FROM STANDARD COLORS.
15. KIM #5012MH277
    (1)175W R40 MH 216W
    DIRECT BURIAL, FLUSH WITH GRADE
16. KIM #5035MH277
    (1)175W MH 216W
    DIRECT BURIAL, FLUSH WITH GRADE

EXIT PRESCOLITE LITE PLATE # LED-R-1-NB-W
LED 2W
SURFACE MOUNT AS SHOWN

SHADED FIXTURES TO HAVE BODINE EMERGENCY BALLAST.

POLES:

CENTRECON SERIES S. #SBQ-5-113-S
(AT FUEL ISLAND)

CENTRECON SERIES M. #MBQ-7-113-S
(PARKING LOT)

AS-BUILT

No.	REVISIONS/SUBMISSIONS	DATE
3		
2		
1		

Zeck|Butler ArchitectsPS

The Paulsen Center Suite 860 West 421 Riverside, Spokane WA 99201 (509) 456-8236/Fax (509) 747-0570
The Edwards Building 1029 West Broadway, Moses Lake WA 98837 (509) 765-8825/Fax (509) 765-8797

PROJECT TITLE
GRANT COUNTY PUBLIC WORKS OFFICE/SHOP COMPLEX
EPHRATA, WA

SHEET TITLE
SITE PLAN - ELECTRICAL

SEAL	DATE 03-08-96	PROJECT NO. 9573 (95184)
DALE R. WACHHOLZ, STATE OF WASHINGTON, 28666, REGISTERED PROFESSIONAL ENGINEER	DRAWN SL	DRAWING NO. E-1
	CHECKED DW	
EXPIRES 7-29-96	REVIEWED DW	

SITE PLAN - ELECTRICAL

1"=40'-0"