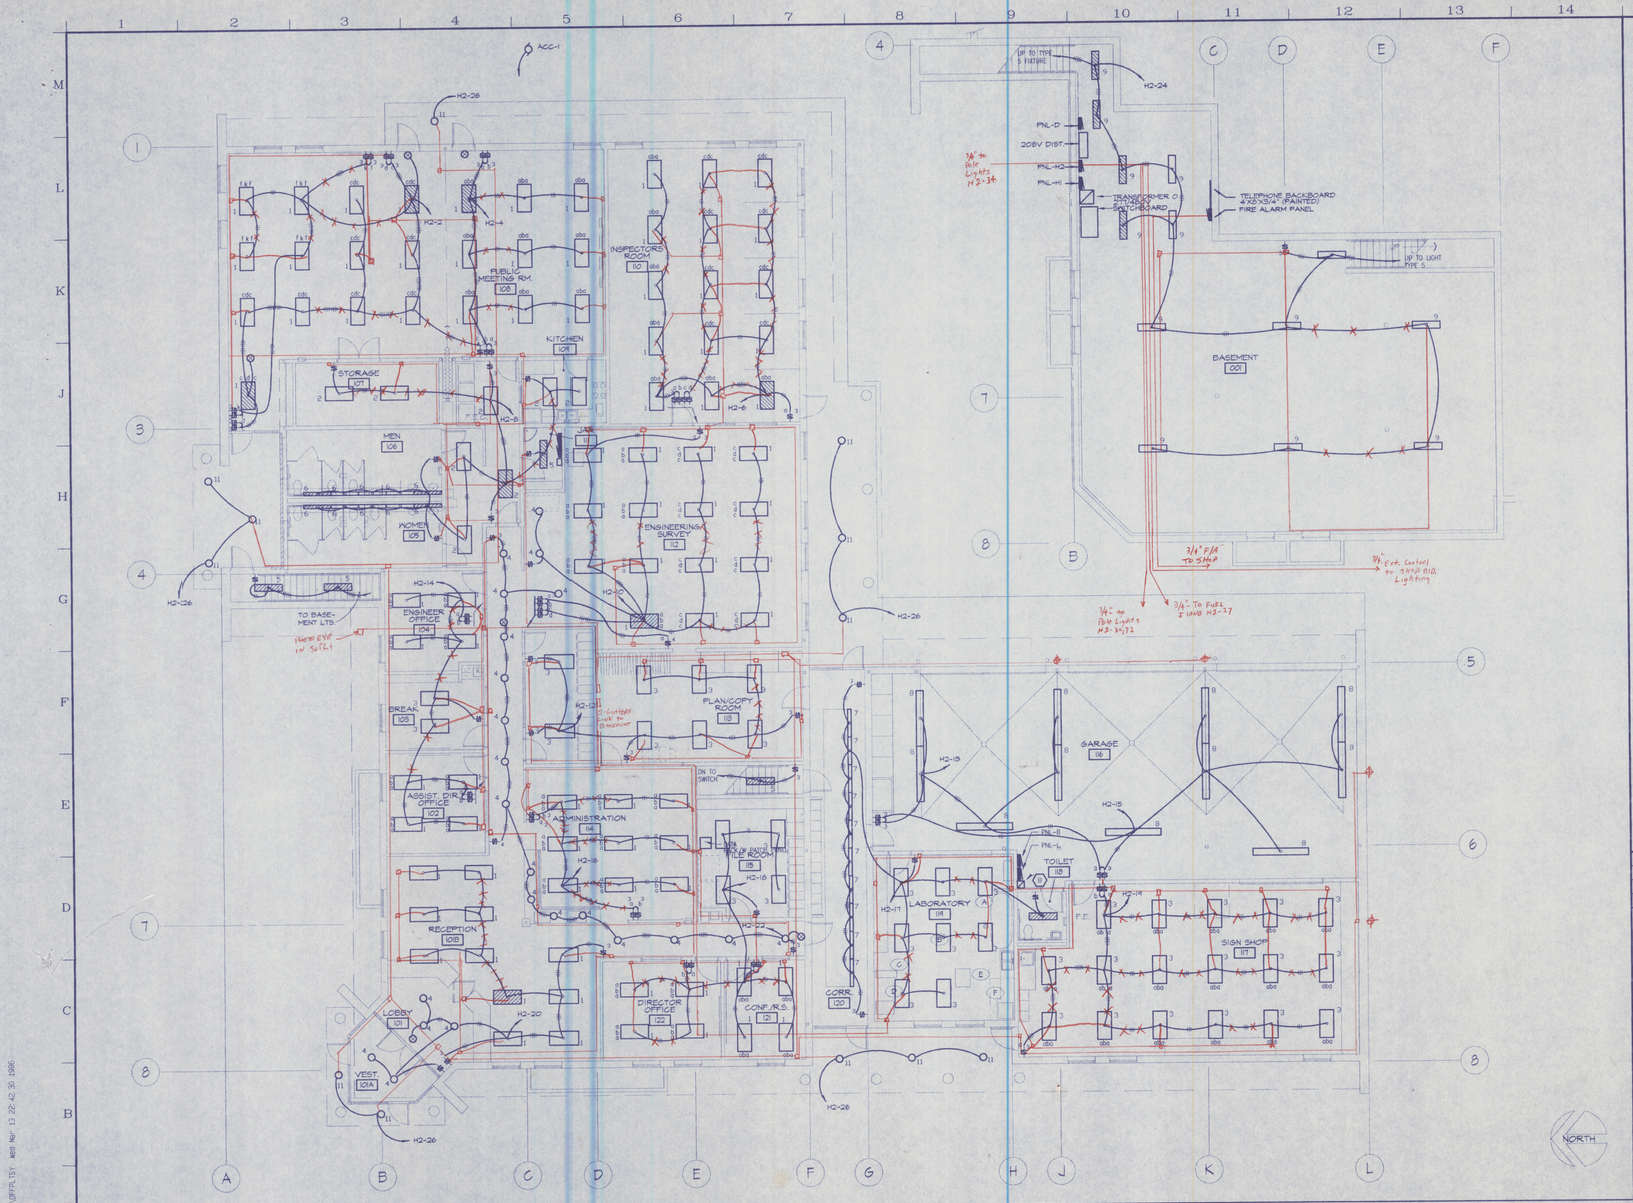

OFFICE BUILDING & BASEMENT - FLOOR PLANS - LIGHTING

1/8"=1'-0"

AS-BUILT

No.	REVISIONS/SUBMISSIONS	DATE
1		
2		
3		

Zeck|Butler Architects PS

The Paulsen Center Suite 550 West 421 Riverside, Spokane WA 99201 (509) 458-8236/Fax (509) 747-0570
The Edwards Building 1029 West Broadway, Moses Lake WA 98837 (509) 765-8525/Fax (509) 765-8797

PROJECT TITLE

GRANT COUNTY PUBLIC WORKS OFFICE/SHOP COMPLEX

EPHRATA, WA

SHEET TITLE

FLOOR PLAN - OFFICE BUILDING

SEAL: DALE K. WATANABE, STATE OF WASHINGTON, 19088, REGISTERED PROFESSIONAL ENGINEER, EXPIRES: 7-29-96

DATE	05-08-96
PROJECT NO.	9515 (45184)
DRAWN	SCL
CHECKED	DRW
REVIEWED	DRW
DRAWING NO.	E-2

J:\GRANT-CO\9515E\OFFFLTBY.mcd May 13 22:42:30 1996