ARCHITECTURAL ABBREVIATIONS

SEE CIVIL, MECH'L & ELEC'L DRAWINGS FOR ADDITIONAL ABBREVIATIONS

A.B.	ANCHOR BOLT	JT.	JOINT
ACT.	ACOUSTICAL TILE		
A/C	AIR CONDITIONING	LAM.	LAMINATE(D)(ION)
A.D.	AREAS DRAIN	LAV.	LAVATORY
A.F.F.	ABOVE FINISH FLOOR	LL.	LIVE LOAD
ALUM.	ALUMINUM	LT.	LIGHT
A.P.	ACCESS PANEL		
A.P.A.	AMERICAN PLYWOOD ASSOCIATION	MAS.	MASONRY
		MECH.	MECHANICAL
ARCH.	ARCHITECT (URAL)	MET.	METAL
		MFR.	MANUFACTURE(ER)
BD.	BOARD	M.H.	MAN HOLE
BET.	BETWEEN	MIN.	MINIMUM
BLDG.	BUILDING	M.O.	MASONRY OPENING
BLK.	BLOCK(ING)	MT.	MOUNT(ED)
B.M.	BENCH MARK	MATL.	MATERIAL
BM.	BEAM		
BOT.	BOTTOM	N.I.C.	NOT IN CONTRACT
BRG.	BEARING	NOM.	NOMINAL
BUR.	BUILT UP ROOFING	N.T.S.	NOT TO SCALE
		NRCA	NATIONAL ROOFING CONTRACTORS ASSOCIATION
CAB.	CABINET		
C.	CAMEBER		
C.B.	CATCH BASIN		
C.F.	CONTRACTOR FURNISHED	O.C.	ON CENTER
CF.	CUBIC FEET	O.D.	OUTSIDE DIAMETER
C.I.	CAST/ IRON	O.F.	OWNER FURNISHED
C.J.	CONTROL JOINT	O.I.	OWNER INSTALLED
CLG.	CEILING	OPG.	OPENING
C.M.T.	CERAMIC MOSAIC TILE	OPP.	OPPOSITE
CMU	CONCRETE MASONRY UNIT		
COL.	COLUMN	PBD.	PARTICLE BOARD
CONC.	CONCRETE	P.C.	PRECAST CONCRETE
CONST.	CONSTRUCTION	P.F.L.	POUNDS PER LINEAL FOOT
CONTR.	CONTRACTOR(S)	P.L.	PROPERTY LINE
CPT.	CARPET	PLAM.	PLASTIC LAMINATE
CTCK.	COUNTERSUNK	PLAS.	PLASTIC
C.T.	CERAMIC TILE	PNL.	PANEL
C.Y.	CUBIC YARD	PNT.	PAINT
		P.S.F.	POUNDS PER SQUARE FOOT
DBL.	DOUBLE	P.S.I.	POUNDS PER SQUARE INCH
D.F.	DRINKING FOUNTAIN	PT.	POINT
DIAG.	DIAGONAL	P.T.D.	PAPER TOWEL DISPENSER
DIA.	DIAMETER	PTN.	PARTITION
DIM.	DIMENSION	PWD.	PLYWOOD
DIV.	DIVISION		
DL.	DEAD LOAD	Q.T.	QUARRY TILE
DR.	DOOR(S)		
D.S.	DOWNSPOUT	R.	RISER
DTL.	DETAIL	R.A.	RETURN AIR
DWG.	DRAWING	R.B.	RUBBER BASE
D.W.	DRYWELL	R.D.	ROOF DRAIN
		REF.	REFERENCE
E.B.	EXPANSION BOLT	REV.	REVISION, REVISED
E.J.	EXPANSION JOINT	RM.	ROOM
EL.	ELEVATION	R.O.	ROUGH OPENING
ELEC.	ELECTRIC(AL)	R.O.W.	RIGHT OF WAY
EPDM	ETHYLENE PROPYLENE DIENE MONOMER	R.T.M.	RUBBER TIRE MAT
		RWC.	RAINWATER CONDUCTOR
EQ.	EQUAL	RWL.	RAINWATER LEADER
EQP.	EQUIPMENT		
E.W.	EACH WAY	S.C.	SOLID CORE
EXG.	EXISTING	SHT.	SHEET
EXH.	EXHAUST	SIM.	SIMILAR
EXP.	EXPOSED	SMACNA	SHEET METAL AND AIR CONDITIONING CONTRACTORS NATIONAL ASSOCIATION
EXT.	EXTERIOR		
F.A.	FIRE ALARM		
F.B.O.	FURNISHED BY OTHERS	SPEC.	SPECIFICATION
F.D.	FLOOR DRAIN	SQ.	SQUARE
F.E.	FIRE EXTINGUISHER	S.S.	STAINLESS STEEL
FIN.	FINISH	ST.	STAIN
FLR.	FLOOR(ING)	SUSP.	SUSPENDED
FLUR.	FLUORESCENT	STN.	STAIN
FND.	FOUNDATION		
FP	FIREPROOF	T.	TREAD
FR.	FRAME(D)(ING)	T.B.	TOWEL BAR
FT.	FOOT	T.C.	TOP OF CURB
FTG.	FOOTING	TEXT.	TEXTURED
FUR.	FURRED(ING)	THK.	THICK(NESS)
		T.P.D.	TOILET PAPER DISPENSER
GA.	GAGE, GAUGE	T.W.	TOP OF WALL
G.B.	GRAB BAR	TYP.	TYPICAL
G.C.	GENERAL CONTRACTOR		
G.I.	GALVANIZED IRON	U.B.C.	UNIFORM BUILDING CODE
GL.	GLASS, GLAZING	U.F.C.	UNIFORM FIRE CODE
GLBM.	GLUE LAMINATED BEAM	UG.	UNDERGROUND
G.W.B.	GYPSUM WALL BOARD	U.N.O.	UNLESS NOTED OTHERWISE
GALV.	GALVANIZED		
		V.B.	VAPOR BARRIER
H.B.	HOSE BIBB	V.C.T.	VINYL COMPOSITION TILE
H.C.	HOLLOW CORE	VERT.	VERTICAL
HDW.	HARDWARE	V.G.	VERTICAL GRAIN
HOR.	HORIZONTAL	VIN.	VINYL
H.M.	HOLLOW METAL	V.T.	VINYL TILE
H.P.	HORSE POWER	V.W.C.	VINYL WALL COVERING
HT.	HEIGHT		
HTG.	HEATING	W.C.	WATER CLOSET
H.W.H.	HOT WATER HEATER	WD.	WOOD
		WIN.	WINDOW
I.D.	INSIDE DIAMETER	WSCT.	WAINSCOT
INCL.	INCLUDE(D)(ING)	W.W.F.	WELDED WIRE FABRIC
INSUL.	INSULATE(D)(ION)		
INT.	INTERIOR		
INV.	INVERT		

SYMBOLS

THE FOLLOWING SYMBOLS IDENTIFY TYPICAL CONDITIONS AND ELEMENTS AND ARE APPLICABLE ONLY IF UTILIZED IN THE DOCUMENTS. REFER TO CIVIL, MECH'L & ELEC'L DRAWINGS FOR SYMBOLS APPLICABLE TO THOSE DIVISIONS OF WORK.

REVISION INDICATION

TEST BORING

PROPERTY LINE OR BOUNDRY LINE

CENTER OR GRID LINE

HIDDEN FEATURE OR RELATIONSHIP

BREAK LINE

F.H. FIRE HYDRANT

M.H. EXISTING MANHOLE

P.P. POWER POLE

—TELE— EXISTING TELEPHONE

—S— EXISTING SANITARY SEWER

—E— EXISTING ELECTRICAL

DOOR OPENING NUMBER

ROOM NUMBER

WINDOW OPENING NUMBER

DETAIL NUMBER

DETAIL INDICATOR

DRAWING NUMBER WHERE DETAIL IS DRAWN

SECTION NUMBER

BUILDING SECTION OR EXTERIOR ELEVATION INDICATOR

DRAWING NUMBER WHERE SECTION IS DRAWN

SECTION NUMBER

SECTION INDICATOR

DRAWING NUMBER WHERE SECTION IS DRAWN

INTERIOR ELEVATION INDICATOR

DRAWING NUMBER WHERE ELEVATION IS DRAWN

ELEVATION NUMBER

KEYED NOTE NUMBER (GENERAL NOTE)

DISCIPLINE PREFIX

GROUP DESIGNATION

SHEET NUMERIC CODE

DRAWING NUMBER

DISCIPLINE PREFIX	DISCIPLINE
G	GENERAL WORK
C	SITE SURVEY/CIVIL
A	ARCHITECTURE
S	STRUCTURAL
T	FUEL DISPENSING
M	MECHANICAL
E	ELECTRICAL

PREFIX NUMBER IDENTIFIES SPECIFICATION SECTION

04250.B MATERIALS KEYING

SUFFIX LETTER IDENTIFIES SPECIFIC ITEM/CROSS REFERENCED TO NOTATION IN LEGEND

GLASS

GYPSUM BOARD

NEW WALLS

ACOUSTICAL CEILING TILE

NEW ASPHALT PAVING

NEW CONCRETE

WALL TYPE IDENTIFIER

NEW DOOR & FRAME

EXISTING DOOR & FRAME

DEMOLISH DOOR & FRAME

FOLDING OR ACCORDIAN PARTITION

WINDOW

EARTH

GRAVEL, CRUSHED ROCK OR OTHER POROUS MATERIAL AS IDENTIFIED

ASPHALT PAVEMENT

CONCRETE

BRICK

CONCRETE MASONRY UNIT(CMU)

CERAMIC OR CLAY TILE AS INDICATED

STEEL

ALUMINUM

PLYWOOD

WOOD BLOCKING

CONTINUOUS WOOD FRAMING

FINISH LUMBER FOR ARCHITECTURAL WOODWORKS

FIBROUS INSULATION

RIGID BOARD INSULATION

LOOSE FILL INSULATION

EXTERIOR INSULATION & FINISH SYSTEM

FIBROUS FIRE SAFING

DRAWING KEYNOTING SYSTEM:

A keynoting system is used on the Drawings for materials and notes. Refer to the keynote legend on the drawing for the information which relates to each keynote symbol on the respective drawing.

Each keynote symbol consists of a 5-digit number followed by a period and a letter suffix. The 5-digit number relates to the specification section which generally covers the item that is referenced, and the letter suffix combined with the 5-digit number and period creates a keynote symbol which identifies the specific reference notation used on the drawing. The letter suffix does not relate to any corresponding reference letter in the specification.

THE ORGANIZATION OF THE KEYNOTING SYSTEM ON THE DRAWINGS, WITH THE KEYNOTE REFERENCE NUMBERS RELATED TO THE SPECIFICATION SECTIONS NUMBERING SYSTEM, SHALL NOT CONTROL THE CONTRACTOR IN DIVIDING THE WORK AMONG SUBCONTRACTORS OR IN ESTABLISHING THE EXTENT OF WORK TO BE PERFORMED BY ANY TRADE.

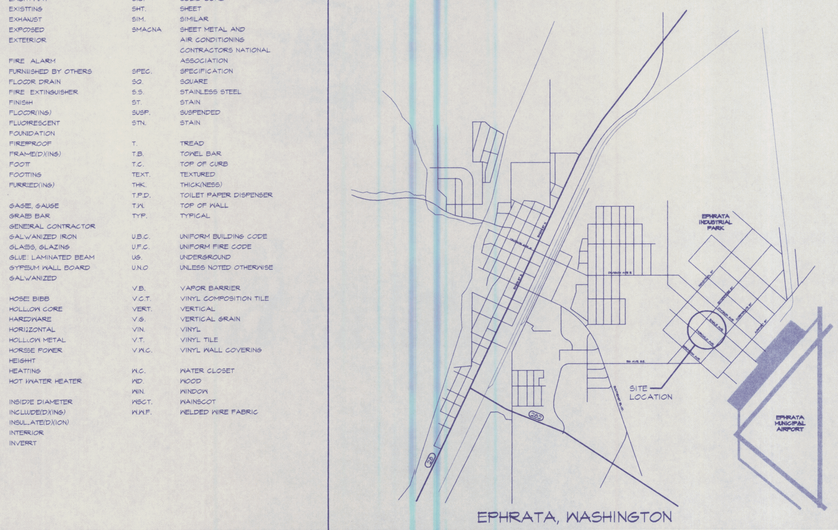

EPHRATA, WASHINGTON

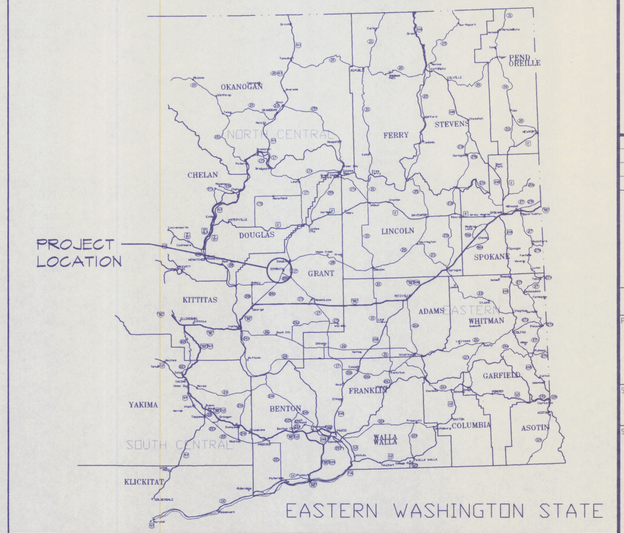

EASTERN WASHINGTON STATE

SHEET INDEX

GENERAL INFORMATION

G1.1 GENERAL INFORMATION SHEET
G1.2 CODE DATA SHEET

CIVIL

C1.1 SITE DEMOLITION PLAN
C1.2 GENERAL SITE INFORMATION SHEET
C1.2.1 SITE DETAILS
C1.3 LAYOUT PLAN
C1.4 SITE GRADING, DRAINAGE
C1.5 SITE GRADING, DRAINAGE
C1.6 CIVIL DETAILS

LANDSCAPING

L1.1 PLANTING PLAN

ARCHITECTURAL

A0.1 BASEMENT FLOOR PLAN - OFFICE BUILDING
A1.1 FLOOR PLAN - OFFICE BUILDING
A1.2 FLOOR PLAN - SHOP BUILDING
A1.3 FLOOR PLAN - SHOP BUILDING
A1.4 EQUIPMENT STORAGE BUILDING - PLAN, ELEVATIONS AND WALL TYPES
A1.5 EQUIPMENT STORAGE BUILDING - PLANS, BUILDING SECTION AND DETAILS
A2.1 ROOM FINISH AND WINDOW SCHEDULES
A2.2 DOOR SCHEDULES AND DETAILS
A2.3 DOOR DETAILS
A2.5 DOOR & WINDOW DETAILS
A2.6 DOOR & WINDOW DETAILS
A2.4 DOOR & WINDOW DETAILS
A3.1 EXTERIOR ELEVATIONS
A3.2 EXTERIOR ELEVATIONS
A3.3 EXTERIOR ELEVATIONS
A3.4 BUILDING SECTIONS
A4.1 WALL SECTIONS
A4.2 WALL SECTIONS
A4.3 WALL SECTIONS
A4.4 WALL SECTIONS
A4.5 WALL SECTIONS
A4.6 WALL SECTIONS
A4.7 WALL SECTIONS
A4.8 WALL SECTIONS
A4.9 WALL SECTIONS
A4.10 WALL SECTIONS
A4.11 WALL SECTIONS
A4.12 WALL SECTIONS
A4.13 WALL SECTIONS
A4.14 WALL SECTIONS
A5.1 ROOF PLAN
A5.2 ROOF DETAILS
A6.1 MISCELLANEOUS DETAILS
A6.2 MISCELLANEOUS DETAILS
A6.3 SIGN DETAILS
A7.1 ENLARGED FLOOR PLANS & INT. ELEVATIONS
A7.2 INTERIOR ELEVATIONS

SHEET INDEX

ARCHITECTURAL (CONT.)

A7.3 INTERIOR ELEVATIONS
A7.4 INTERIOR ELEVATIONS
A8.1 REFLECTED CEILING PLAN - OFFICE BUILDING
A8.2 REFLECTED CEILING PLAN - SHOP BUILDING

STRUCTURAL

S0.1 STRUCTURAL NOTES & TYPICAL DETAILS
S2.1 OFFICE BUILDING BASEMENT FLOOR/FOUNDATION PLAN AND DETAILS
S2.2 OFFICE BUILDING FLOOR/FOUNDATION PLAN
S2.3 OFFICE BUILDING ROOF FRAMING PLAN AND DETAILS
S2.4 SHOP BUILDING SOUTH WING FLOOR/FOUNDATION PLAN AND DETAILS
S2.5 SHOP BUILDING NORTH WING FLOOR/ FOUNDATION AND CRANE BEAM PLANS
S2.6 SHOP BUILDING SOUTH WING ROOF FRAMING PLAN AND DETAILS
S2.7 SHOP BUILDING NORTH WING ROOF FRAMING PLAN AND DETAILS
S2.8 EQUIPMENT STORAGE BUILDING PLANS AND DETAILS
S8.1 BRACED FRAME AND WALL ELEVATIONS AND DETAILS
S4.1 DETAILS
S4.2 DETAILS
S5.1 DETAILS
S5.2 DETAILS

FUEL

T1 TANK AND ISLAND PLAN
T2 ISLAND ELEVATIONS AND SECTIONS
T3 PIPING AND ELECTRICAL PLAN
T4 TANK ELEVATION AND DETAILS

MECHANICAL

M0.1 LEGEND & SYMBOLS
M0.2 LEGEND & EQUIPMENT SCHEDULES
M1.1 SITE PLAN - MECHANICAL
M2.1 OFFICE BUILDING - FOUNDATION PLAN - PLUMBING
M2.2 SHOP BUILDING I - FOUNDATION PLAN - PLUMBING
M2.3 SHOP BUILDING II - FOUNDATION PLAN - PLUMBING
M2.4 OFFICE BUILDING - FLOOR PLAN - PLUMBING
M2.5 SHOP BUILDING I - FLOOR PLAN - PLUMBING
M2.6 SHOP BUILDING II - FLOOR PLAN - PLUMBING
M2.7 TRUCK WASH - FLOOR PLAN - PLUMBING
M3.1 OFFICE BUILDING - FLOOR AND BASEMENT PLAN - HVAC
M3.2 SHOP BUILDING I - FLOOR PLAN - HVAC
M3.3 SHOP BUILDING II - FLOOR PLAN - HVAC
M3.4 TRUCK WASH - FLOOR PLAN - HVAC
M4.1 TOILET ROOM PLANS
M5.1 DETAILS
M5.2 DETAILS & MEZZANINE SECTIONS

ELECTRICAL

E-1 SITE PLAN - ELECTRICAL
E-2 OFFICE BUILDING AND BASEMENT - FLOOR PLANS - LIGHTING
E-3 OFFICE BUILDING AND BASEMENT - FLOOR PLAN - POWER/SYSTEMS
E-4 SHOP BUILDING 1 - FLOOR PLAN - LIGHTING
E-5 SHOP BUILDING 1 - FLOOR PLAN - POWER/SYSTEMS
E-6 SHOP BUILDING 2 - FLOOR PLAN - LIGHTING
E-7 SHOP BUILDING 2 - FLOOR PLAN - POWER/SYSTEMS
E-8 COVERED STORAGE - FLOOR PLAN - LIGHTING/POWER/SYSTEMS
E-9 POWER RISER DIAGRAM

No.	REVISIONS/SUBMISSIONS	DATE
	AS-BUILT	

Zeck|Butler ArchitectsPS

The Poulsen Center Suite 850 · West 421 Riverside, Spokane WA 99201 · (509) 456-8236/Fax (509) 747-0539
The Edwards Building · 1029 West Broadway, Moses Lake WA 98837 · (509) 765-8825/Fax (509) 765-8757

PROJECT TITLE

GRANT COUNTY PUBLIC WORKS OFFICE/SHOP COMPLEX

EPHRATA, WASHINGTON

SHEET TITLE

GENERAL INFORMATION SHEET

SEAL

5974 REGISTERED ARCHITECT
KENT D. CHADWELL
STATE OF WASHINGTON

DATE	3/8/96
PROJECT NO.	9512
DRAWN	CAH
CHECKED	KDC
REVIEWED	MAP/KDC
DRAWING NO.	G1.1

F:\9512\9512011 3-17-96 2:27:18 pm EST