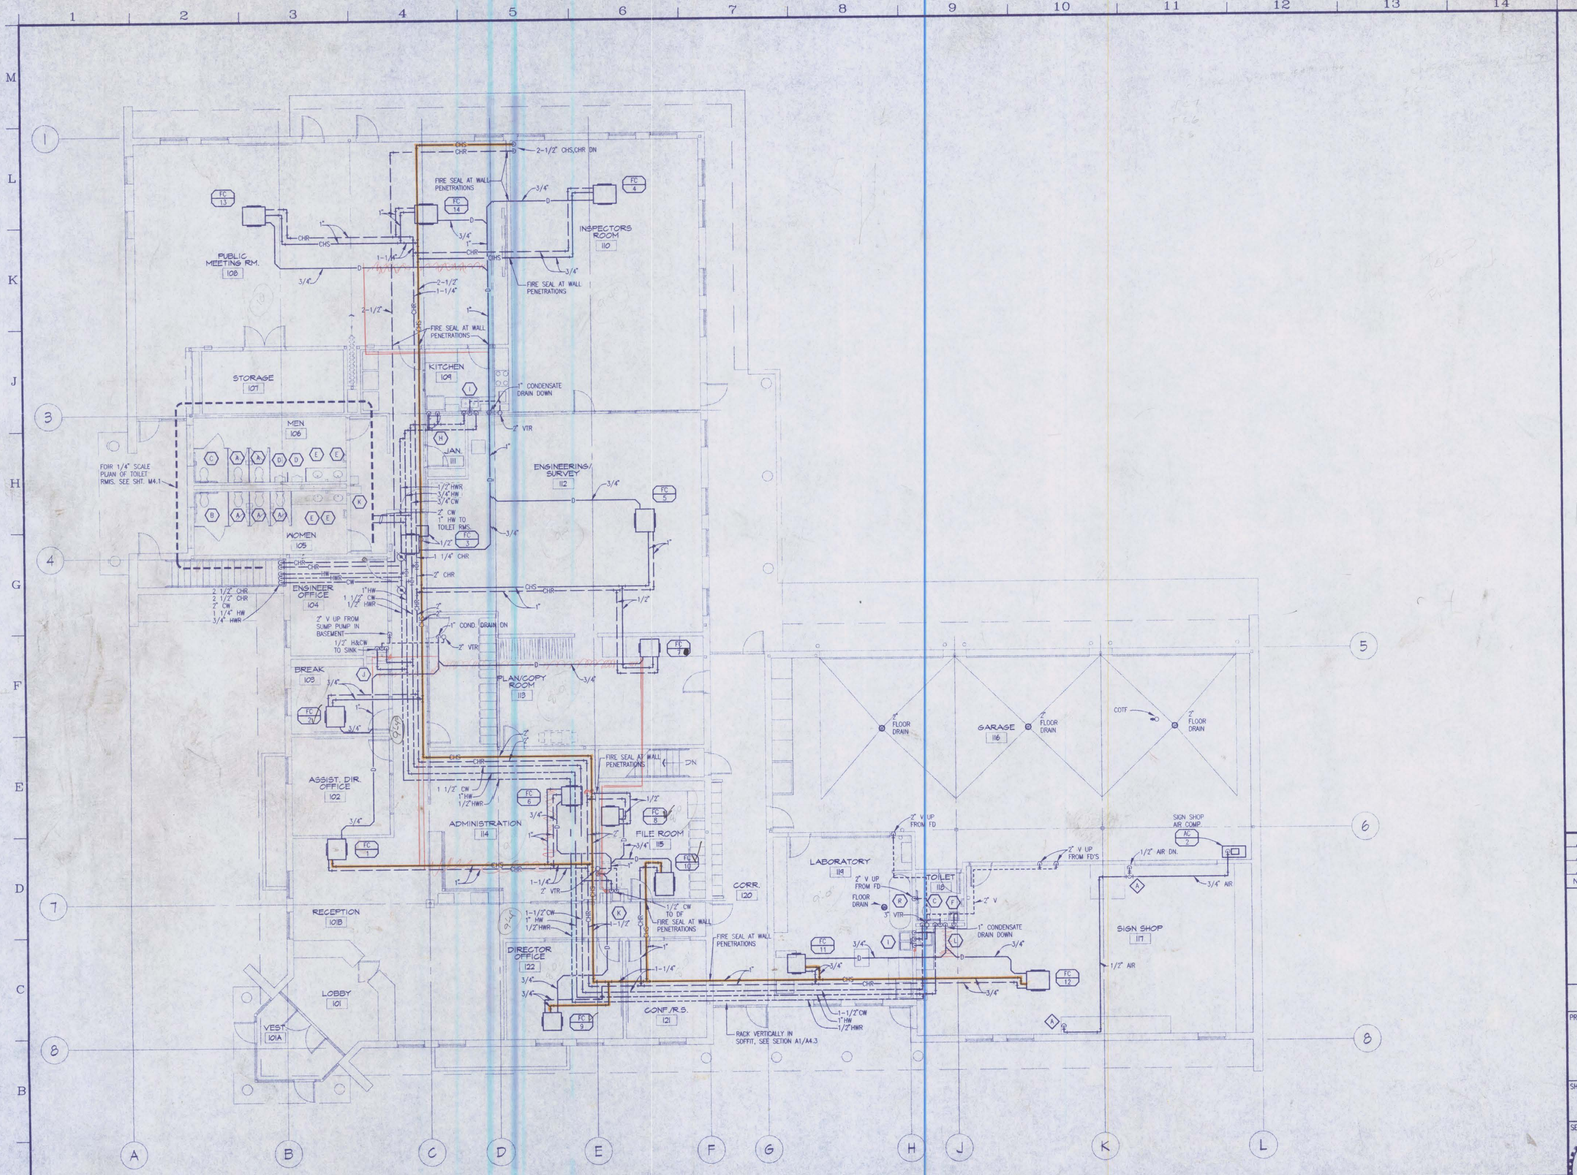

A1	OFFICE BUILDING & BASEMENT FLOOR PLANS - PLUMBING
1/8"=1'-0"	

AS-BUILT

No.	REVISIONS/SUBMISSIONS	DATE
1		
2		
3		

Zeck|Butler Architects PS
The Paulsen Center Suite 860 West 421 Riverside, Spokane WA 99201 (509) 456-8336/Fax (509) 747-0570
The Edwards Building 1929 West Broadway, Moses Lake WA 98837 (509) 765-8825/Fax (509) 765-8797

PROJECT TITLE
GRANT COUNTY PUBLIC WORKS
OFFICE/SHOP COMPLEX
EPHRATA, WA

SHEET TITLE
OFFICE BUILDING - FLOOR PLAN - PLUMBING

SEAL: DAVID G. REAMER, STATE OF WASHINGTON, 20960, REGISTERED PROFESSIONAL ENGINEER, EXPIRES 6/19/97

DATE	9/8/96
DRAWN	JLH
CHECKED	DGR
REVIEWED	DWS

PROJECT NO. 4513 (45214)
DRAWING NO. M2.4

A:\GRANT-CO\DGR\BMMCAD.DGF Thu Mar 14 08:45:06 1996