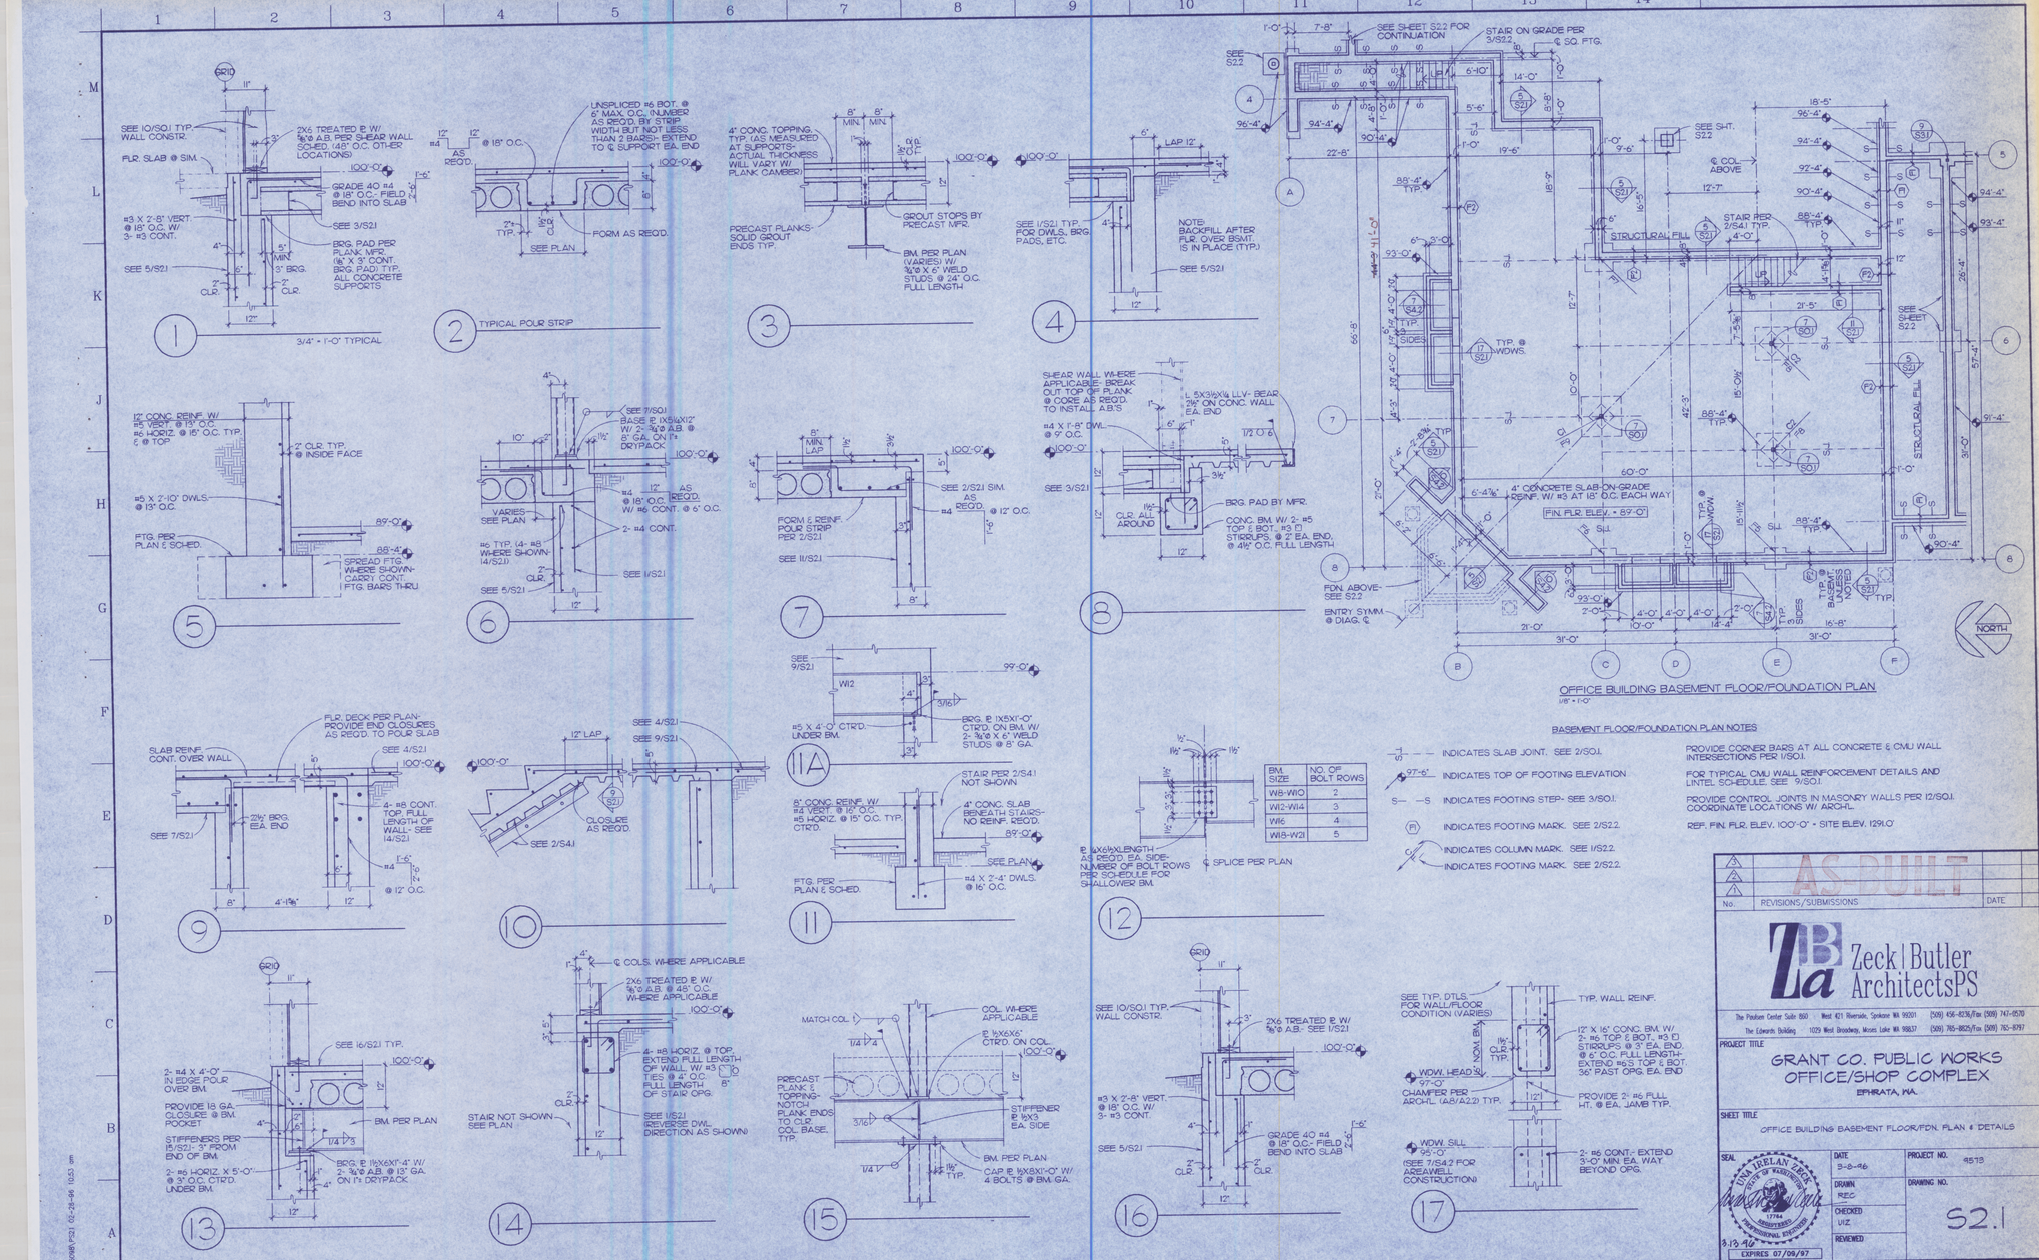

BM. SIZE	NO. OF BOLT ROWS
W8-W10	2
W12-W14	3
W16	4
W18-W21	5

BASEMENT FLOOR/FOUNDATION PLAN NOTES

- S-1 — — INDICATES SLAB JOINT. SEE 2/S0.1.
- 97'-6" INDICATES TOP OF FOOTING ELEVATION.
- S— —S INDICATES FOOTING STEP- SEE 3/S0.1.
- (F1) INDICATES FOOTING MARK. SEE 2/S2.2.
- C1 INDICATES COLUMN MARK. SEE 1/S2.2.
- F1 INDICATES FOOTING MARK. SEE 2/S2.2.

PROVIDE CORNER BARS AT ALL CONCRETE & CMU WALL INTERSECTIONS PER 1/S0.1.

FOR TYPICAL CMU WALL REINFORCEMENT DETAILS AND LINTEL SCHEDULE, SEE 9/S0.1.

PROVIDE CONTROL JOINTS IN MASONRY WALLS PER 12/S0.1. COORDINATE LOCATIONS W/ ARCH'L.

REF. FIN. FLR. ELEV. 100'-0" = SITE ELEV. 1291.0'

No.	REVISIONS/SUBMISSIONS	DATE
3	AS BUILT	
2		
1		

Zeck | Butler ArchitectsPS
The Paulsen Center Suite 850 | West 421 Riverside, Spokane WA 99201 | (509) 456-8236/Fax (509) 747-0570
The Edwards Building | 1029 West Broadway, Moses Lake WA 98837 | (509) 765-8825/Fax (509) 765-8797

PROJECT TITLE
GRANT CO. PUBLIC WORKS OFFICE/SHOP COMPLEX
EPHRATA, WA.

SHEET TITLE
OFFICE BUILDING BASEMENT FLOOR/FDN. PLAN & DETAILS

SEAL: LINA IRELAN ZECK, STATE OF WASHINGTON, 17764, REGISTERED PROFESSIONAL ENGINEER — 8.13.96 — EXPIRES 07/09/97

DATE	9-6-96
DRAWN	REC
CHECKED	LIZ
REVIEWED	
PROJECT NO.	4513
DRAWING NO.	S2.1

C:\ACAD12\JOBS\BP\S2.1 02-28-96 10:53 am