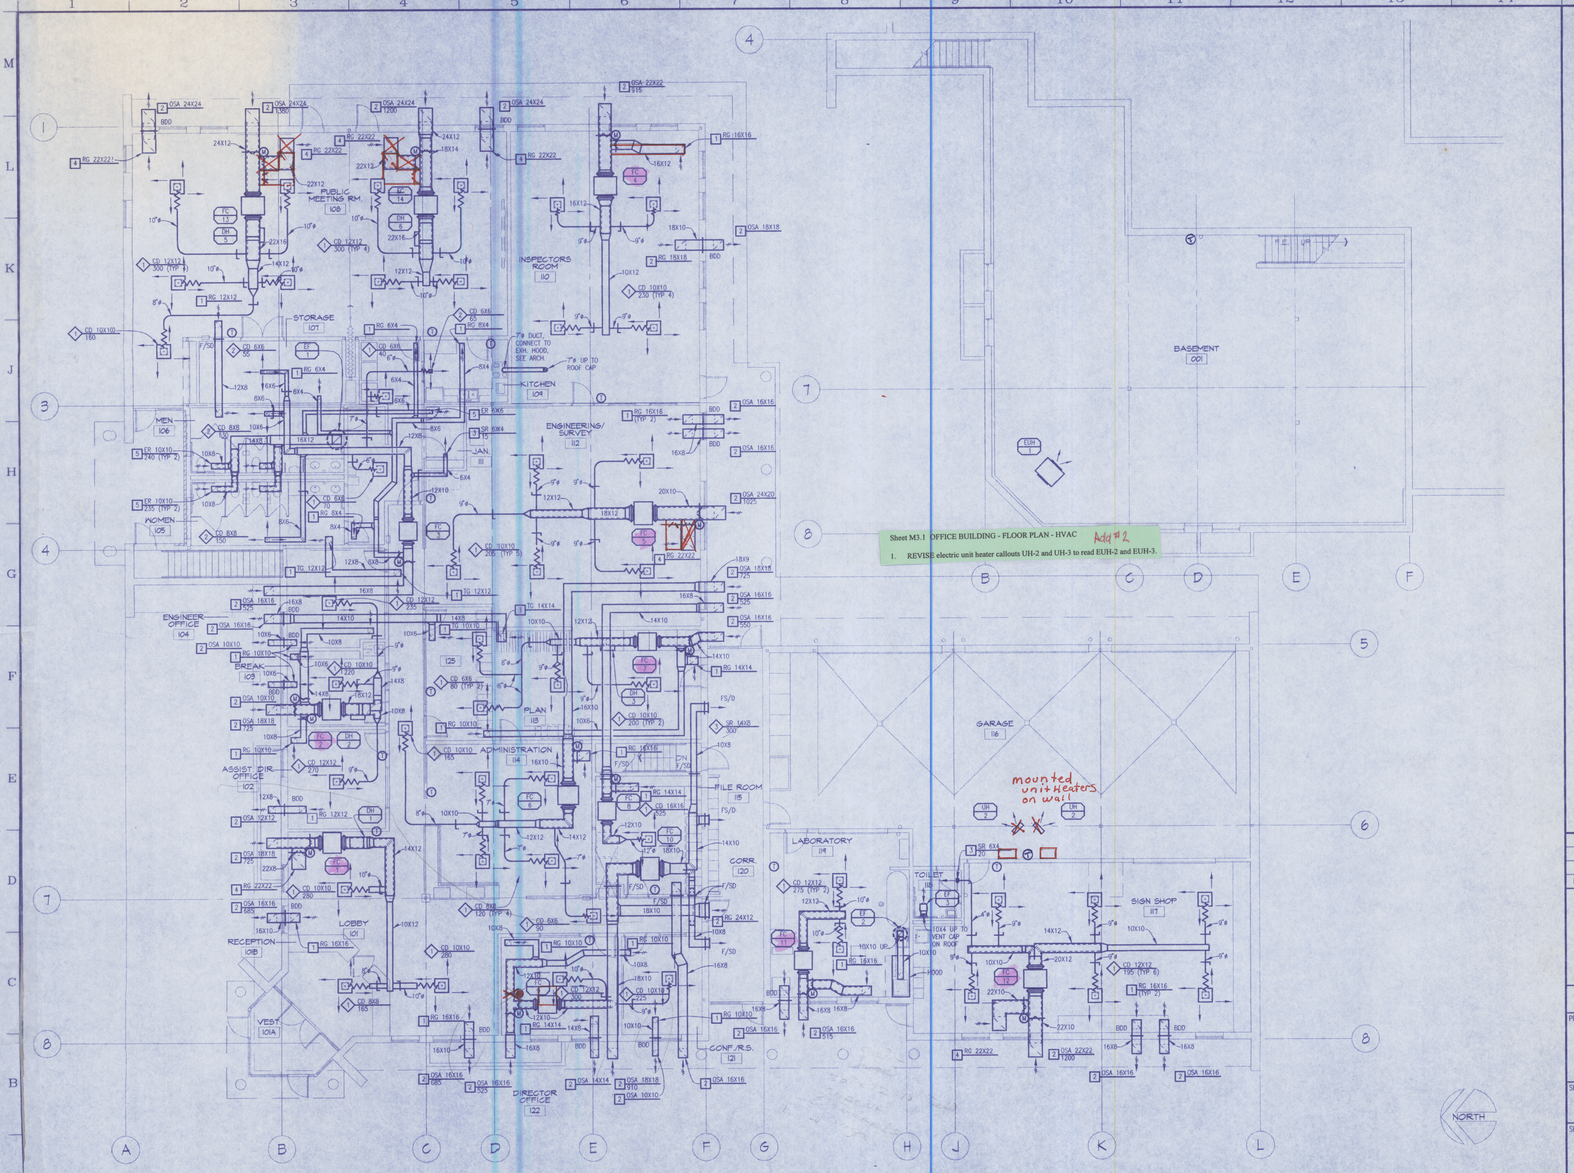

Sheet M3.1 OFFICE BUILDING - FLOOR PLAN - HVAC Add #2

1. REVISE electric unit heater callouts UH-2 and UH-3 to read EUH-2 and EUH-3.

AS-BUILT

No.	REVISIONS/SUBMISSIONS	DATE
3		
2		
1		

Zeck|Butler ArchitectsPS

The Poulsen Center Suite 860 West 421 Riverside, Spokane WA 99201 (509) 456-8236/Fax (509) 747-0570
The Edwards Building 1029 West Broadway, Moses Lake WA 98837 (509) 765-8825/Fax (509) 765-8797

PROJECT TITLE

GRANT COUNTY PUBLIC WORKS
OFFICE/SHOP COMPLEX
EPHRATA, WA

SHEET TITLE

OFFICE BUILDING - FLOOR & BASEMENT PLANS - HVAC

SEAL

DAVID G. REAMER, STATE OF WASHINGTON, 22659, REGISTERED PROFESSIONAL ENGINEER

EXPIRES 4/16/97

DATE	3/8/96
PROJECT NO.	9573 (95184)
DRAWN	JLH
CHECKED	DGR
REVIEWED	DGR
DRAWING NO.	M3.1

M3.1 OFFICE BUILDING & BASEMENT FLOOR PLANS - HVAC

1/8"=1'-0"