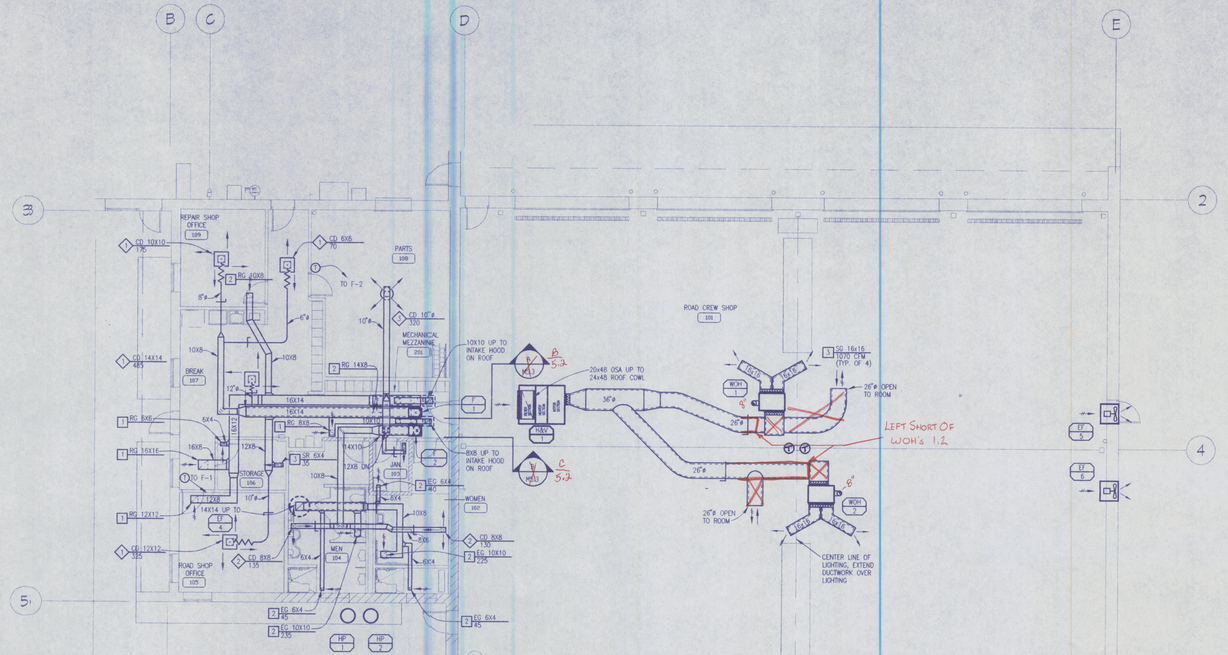

Sheet M3.2 SHOP BUILDING 1 - FLOOR PLAN - HVAC

1. REVISE section callout A-5.3 to read B-5.2 and B-5.3 to read C-5.2. ADD #2, Page 4
2. ADD 8" dia. type L flue through roof with flashing and termination cap at waste oil heaters WOH#1 and WOH#2.

REF. NORTH

AS-BUILT

No.	REVISIONS/SUBMISSIONS	DATE
3		
2		
1		

Zeck|Butler ArchitectsPS
The Paulsen Center Suite 860 West 421 Riverside, Spokane WA 99201 (509) 456-8236/Fax (509) 747-0570
The Edwards Building 1029 West Broadway, Moses Lake WA 98837 (509) 765-8825/Fax (509) 765-8797

PROJECT TITLE
GRANT COUNTY PUBLIC WORKS OFFICE/SHOP COMPLEX
EPHRATA, WA

SHEET TITLE
SHOP BUILDING 1 - FLOOR PLAN - HVAC

SEAL: DAVID G. REAMER, STATE OF WASHINGTON, REGISTERED PROFESSIONAL ENGINEER, EXPIRES 4/16/97

DATE	3/8/96
DRAWN	JLH
CHECKED	DSR
REVIEWED	DSR
PROJECT NO.	9513 (9521A)
DRAWING NO.	M3.2

A1 | SHOP BUILDING 1 FLOOR PLAN - HVAC | 1/8"=1'-0"

J:\GRANT-CO\9521A\M3SHVAC Thu Mar 14 08:27:02 1996