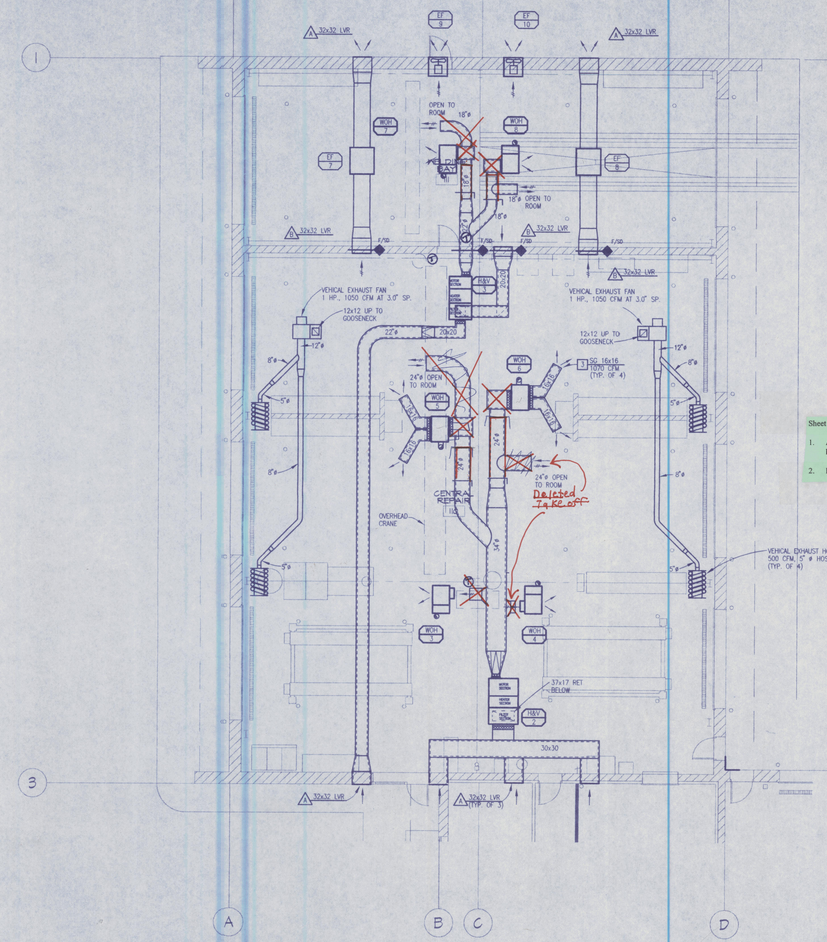

Sheet M3.3 SHOP BUILDING II - FLOOR PLAN - HVAC

1. ADD 8" dia. type L flue through roof with flashing and termination cap at waste oil heaters WOH#3, WOH#4, WOH#5, WOH#6, WOH#7 and WOH#8.
2. DELETE makeup air outlets shown near WOH#3 and WOH#4. Add #2

REF. NORTH

NORTH

AS-BUILT

No.	REVISIONS/SUBMISSIONS	DATE
1		
2		
3		

Zeck|Butler ArchitectsPS

The Poulsen Center Suite 860 West 421 Riverside, Spokane WA 99201 (509) 456-8134/Fax (509) 747-6570
The Edwards Building 1029 West Broadway, Moses Lake WA 98837 (509) 765-8825/Fax (509) 765-8767

PROJECT TITLE
GRANT COUNTY PUBLIC WORKS OFFICE/SHOP COMPLEX
EPHRATA, WA

SHEET TITLE
SHOP BUILING II - FLOOR PLAN - HVAC

SEAL: DAVID G. REAMER, STATE OF WASHINGTON, 12903, REGISTERED PROFESSIONAL ENGINEER, EXPIRES 6/16/97

DATE	3/6/96
PROJECT NO.	9573 (95214)
DRAWN	JLH
CHECKED	DGR
REVIEWED	DMB
DRAWING NO.	M3.3

A1	SHOP BUILDING II FLOOR PLAN - HVAC
1/8"=1'-0"	

J:\GRANT-CO\9573M\M3SHVAC Thu Mar 14 08:22:23 1996