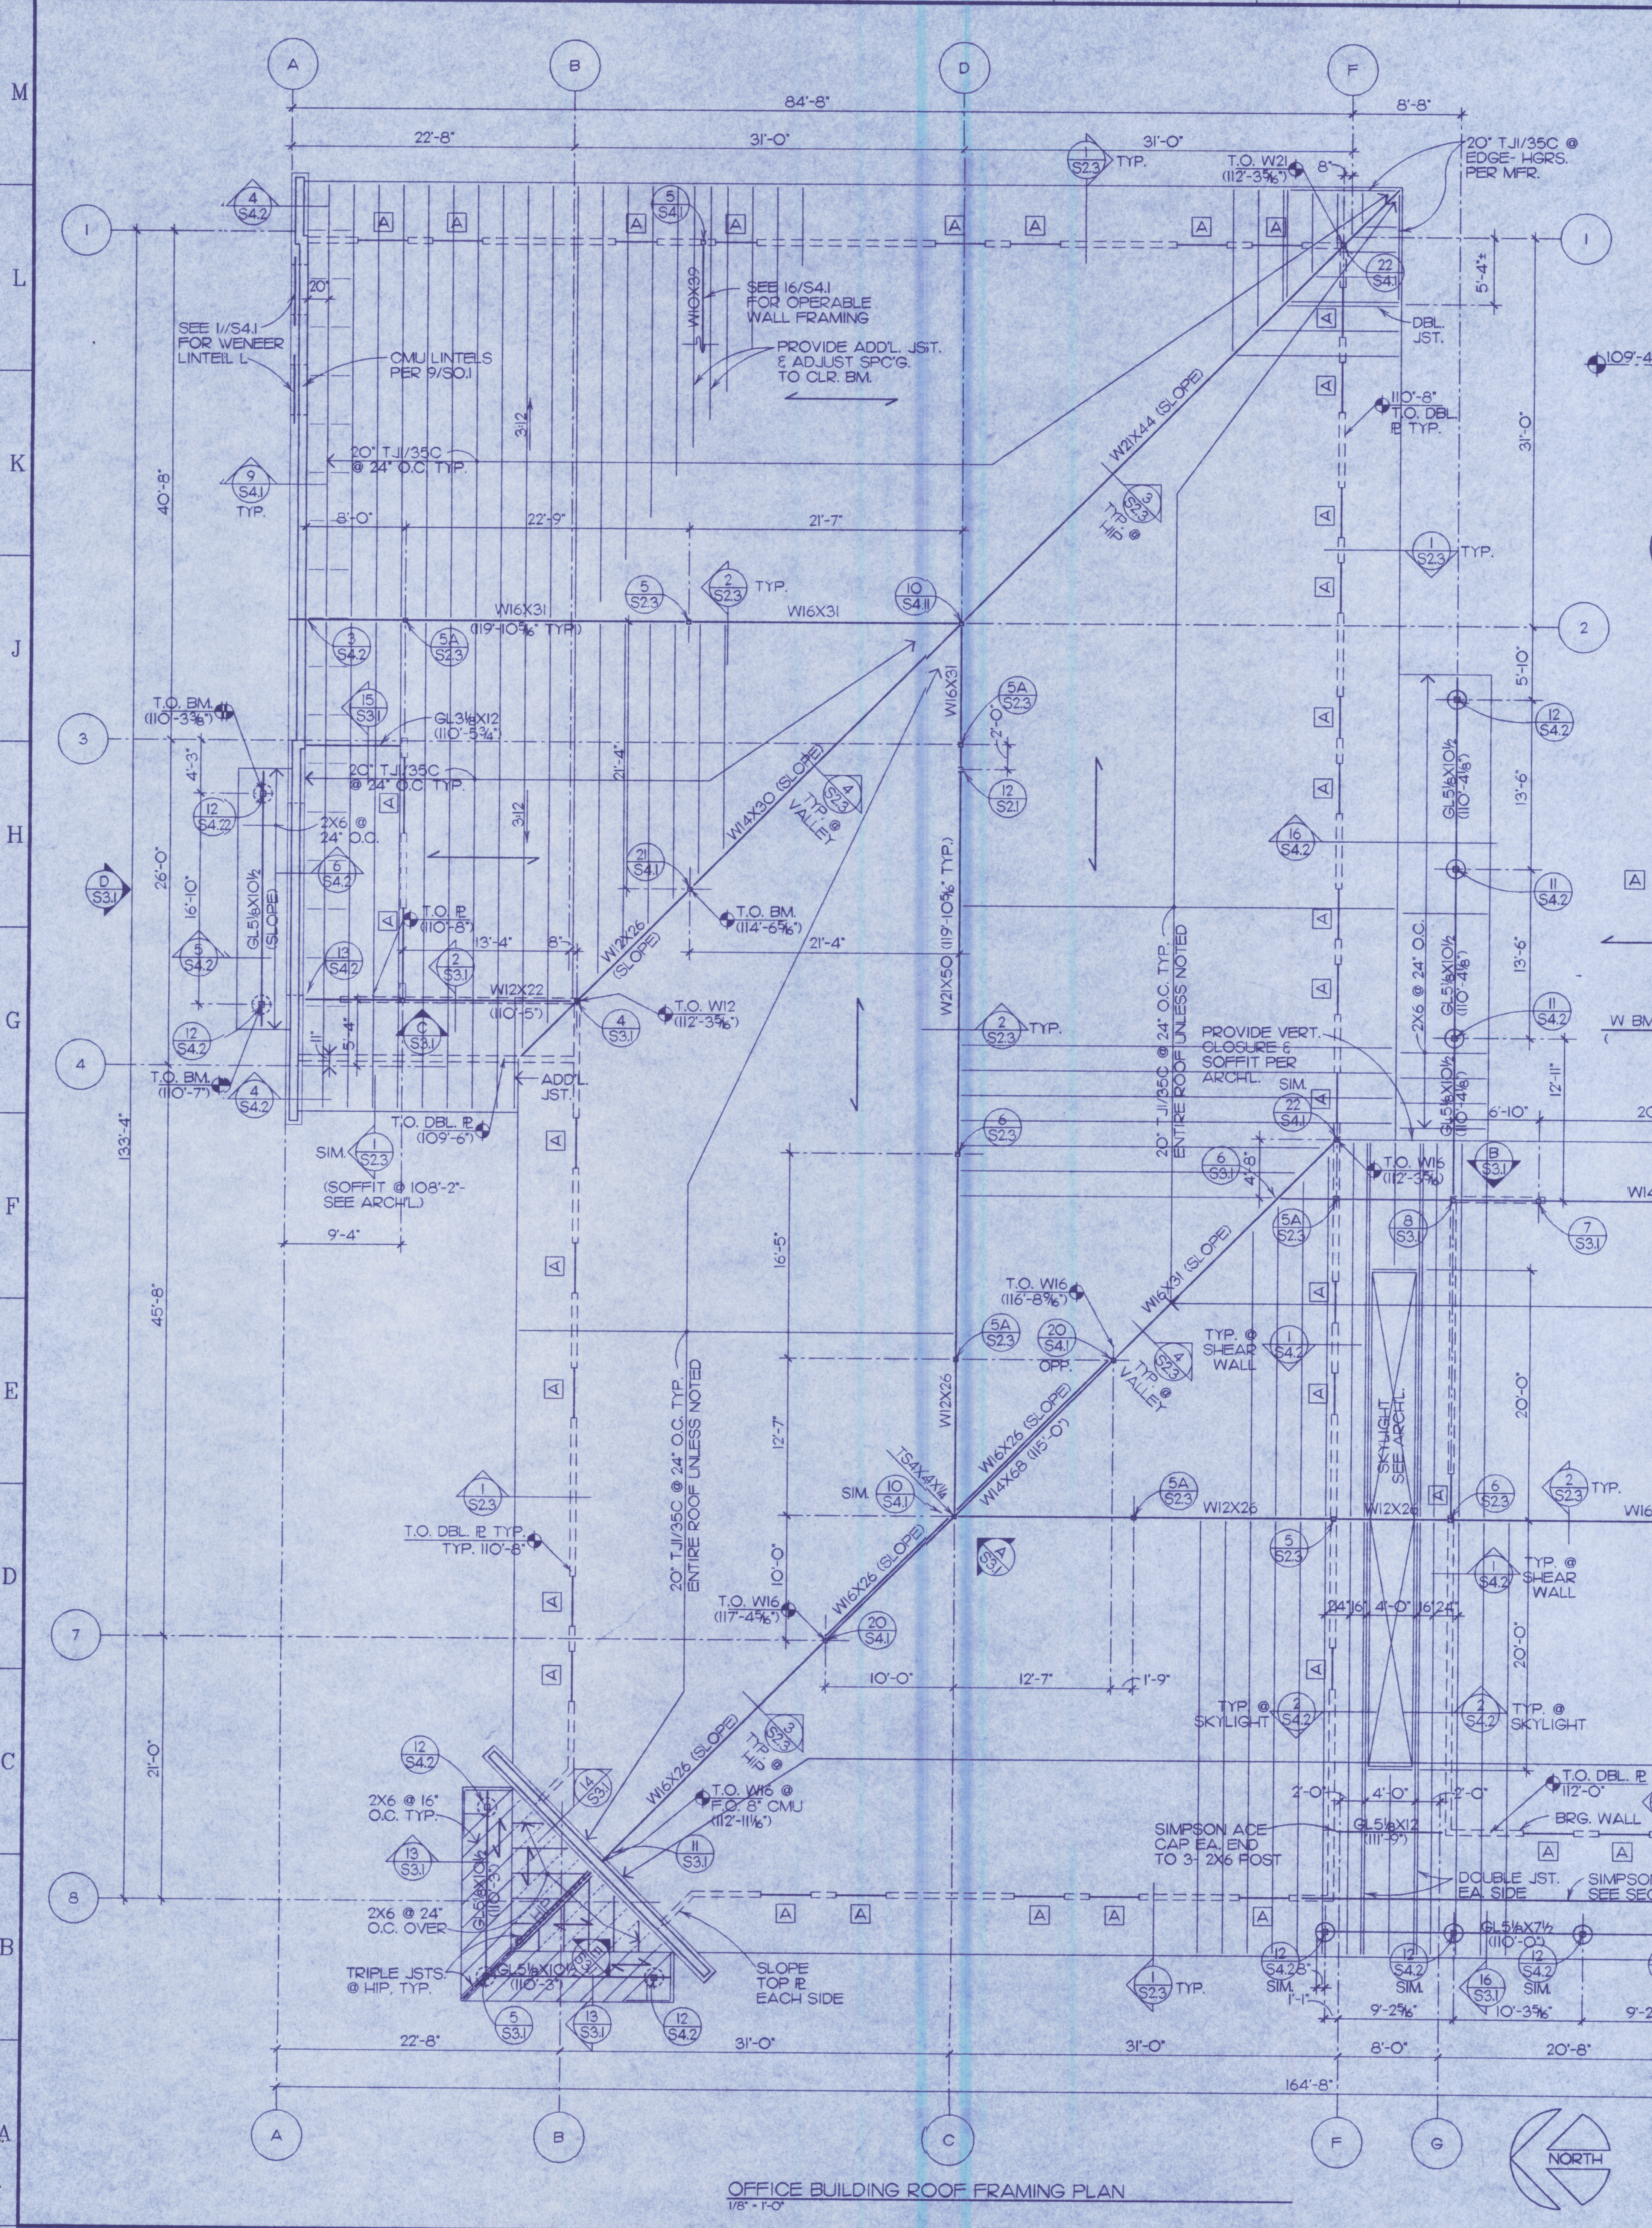

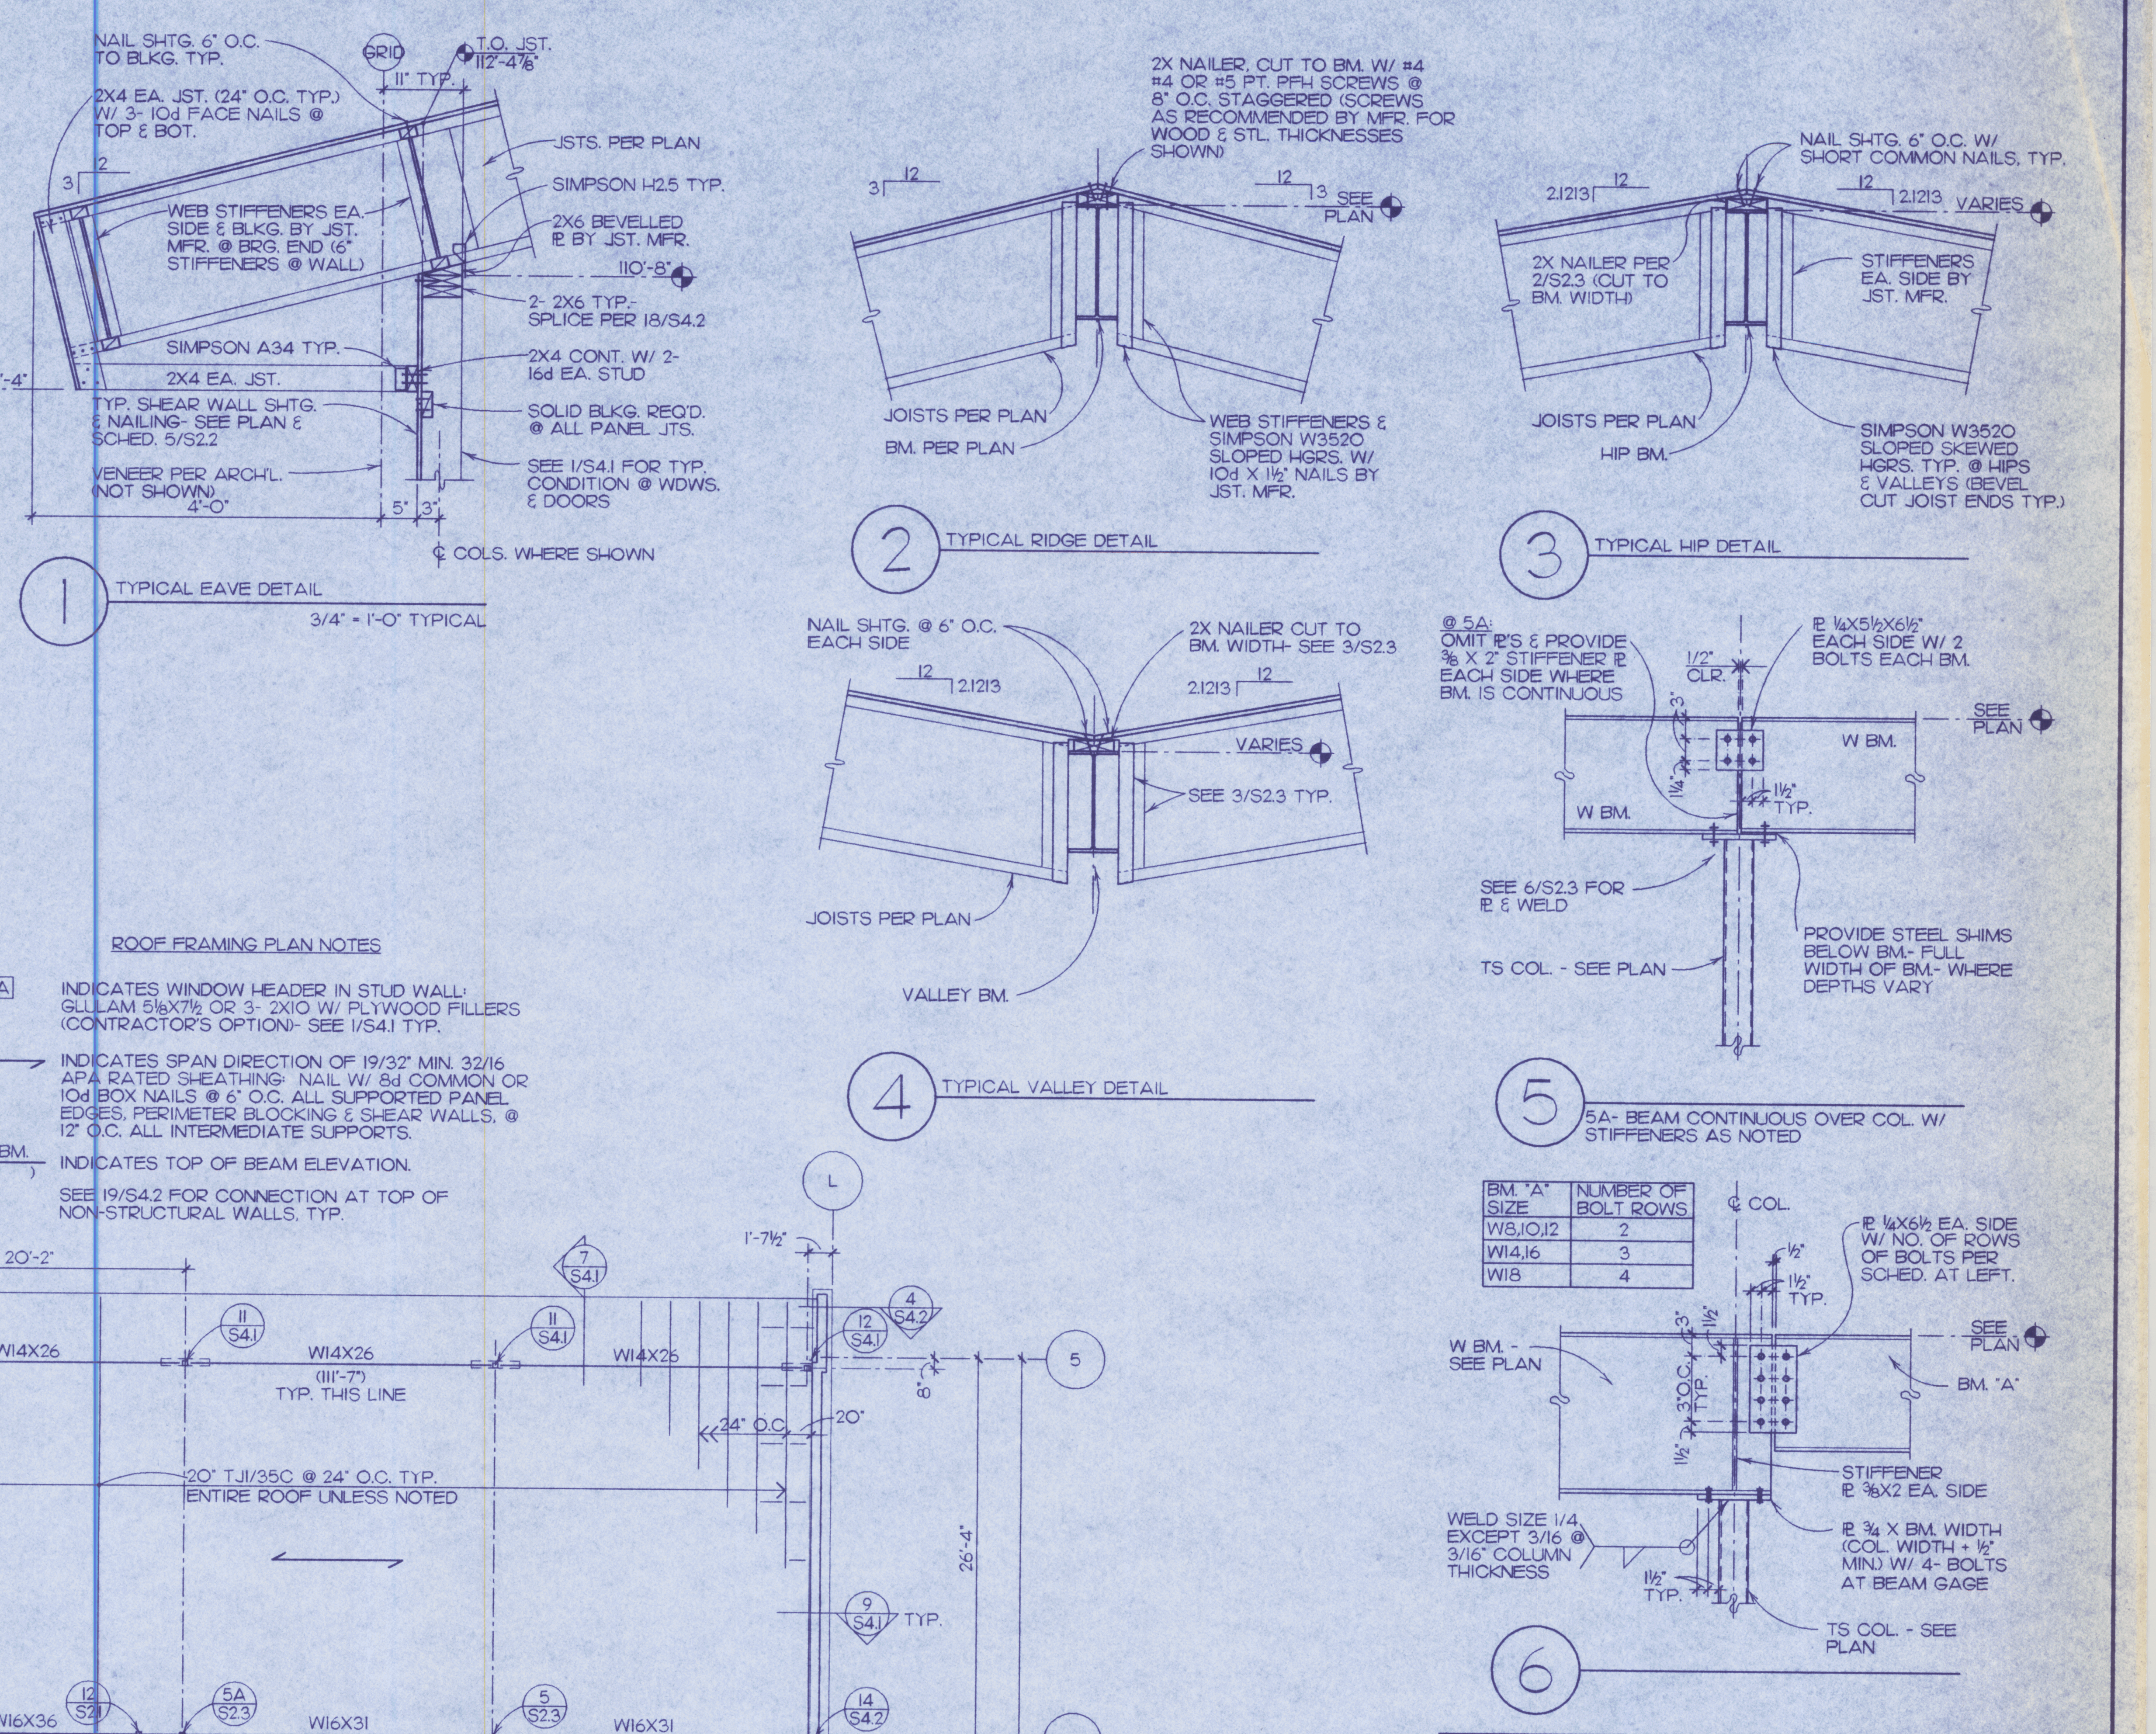

BM. "A" SIZE	NUMBER OF BOLT ROWS
W8,10,12	2
W14,16	3
W18	4

ROOF FRAMING PLAN NOTES

[A] INDICATES WINDOW HEADER IN STUD WALL: GLULAM 5⅛X7½ OR 3- 2X10 W/ PLYWOOD FILLERS (CONTRACTOR'S OPTION)- SEE 1/S4.1 TYP.

←→ INDICATES SPAN DIRECTION OF 19/32" MIN. 32/16 APA RATED SHEATHING: NAIL W/ 8d COMMON OR 10d BOX NAILS @ 6" O.C. ALL SUPPORTED PANEL EDGES, PERIMETER BLOCKING & SHEAR WALLS, @ 12" O.C. ALL INTERMEDIATE SUPPORTS.

W BM. ( ) INDICATES TOP OF BEAM ELEVATION.

SEE 19/S4.2 FOR CONNECTION AT TOP OF NON-STRUCTURAL WALLS, TYP.

No.	REVISIONS/SUBMISSIONS	DATE
3	AS-BUILT	
2		
1		

Zeck | Butler ArchitectsPS

The Paulsen Center Suite 860 West 421 Riverside, Spokane WA 99201 (509) 456-8236/Fax (509) 747-0570
The Edwards Building 1029 West Broadway, Moses Lake WA 98837 (509) 765-8825/Fax (509) 765-8797

PROJECT TITLE

GRANT CO. PUBLIC WORKS OFFICE/SHOP COMPLEX
EPHRATA, WA.

SHEET TITLE

OFFICE BUILDING ROOF FRAMING PLAN AND DETAILS

SEAL: UNA IRELAN ZECK, STATE OF WASHINGTON, 17764, REGISTERED PROFESSIONAL ENGINEER
3.13.96
EXPIRES 07/09/97

DATE	PROJECT NO.
3-8-96	9573
DRAWN: REC	DRAWING NO.
CHECKED: UIZ	S2.3
REVIEWED	