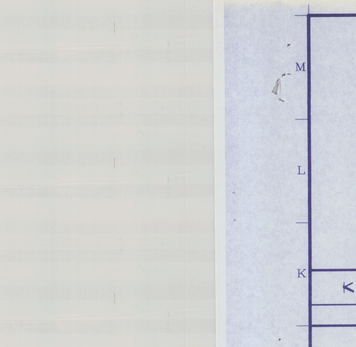

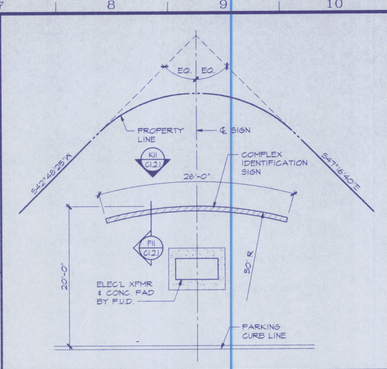

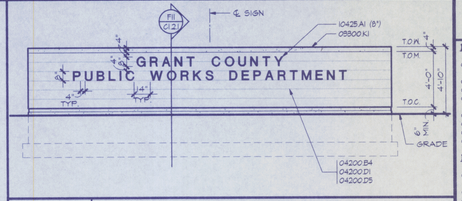

MATERIALS KEYING LEGEND

DIV 2 SITEWORK

02200.B1 COMPACTED SUBGRADE

02520.A2 4" CONCRETE
02520.A3 6" CONCRETE
02520.B1 CONCRETE CURB

02831.A2 6' HIGH CHAIN LINK FENCE
02831.A3 8' HIGH CHAIN LINK FENCE
02831.B2 DOUBLE LEAF SWING GATE
02831.E1 VINYL SCREENING INSERTS

DIV 3 CONCRETE

03300.A3 CONC. SLAB - REFER TO PLANS & OTHER DETAILS FOR THICKNESS & REINFORCEMENT
03300.C2 CONCRETE BASE
03300.J2 #4 @ 18" O.C. EA. WAY
03300.J4 #4 CONT.
03300.K1 CAST-IN-PLACE 4" CONC. CAP WITH TOOLED CONTROL JOINTS EQ. SPACED, 4'-0" MAX. O.C.
03800.M3 ISOLATION JOINT

DIV 4 MASONRY

04200.B4 8" CMU
04200.D1 SPLIT FACE FINISH
04200.D5 INTEGRAL COLOR CMU

DIV 5 METALS

05500.D1 6" DIA. STL. PIPE BOLLARD WITH CONCRETE FILL
05500.D2 8" DIA. STL. PIPE BOLLARD WITH CONCRETE FILL

DIV 9 FINISHES

09900.A1 PAINT FINISH

DIV 10 SPECIALTIES

10425.A1 METAL LETTERS

K1		
J4	PROJECT SIGN	½"=1'-0"
K11	IDENTIFICATION SIGN	¼"=1'-0"
	ELEVATION	

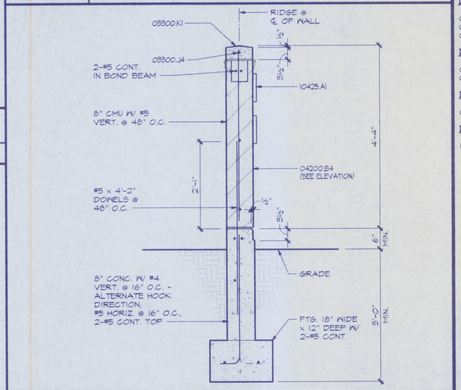

G1		
E4	MECHANICAL CHILLER PAD	⅛"=1'-0"
J7	IDENTIFICATION SIGN	⅛"=1'-0"
	PLAN VIEW LAYOUT	
F11	IDENTIFICATION SIGN	¾"=1'-0"
	SECTION	

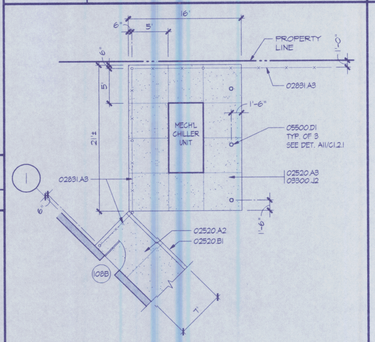

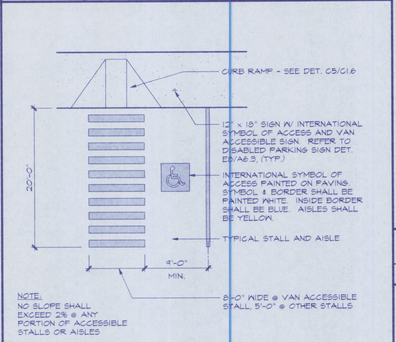

D1		
E4	MECHANICAL CHILLER PAD	⅛"=1'-0"
E7	HANDICAP PARKING STALL	⅛"=1'-0"

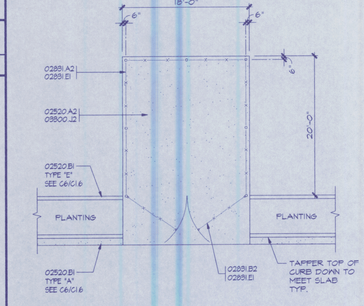

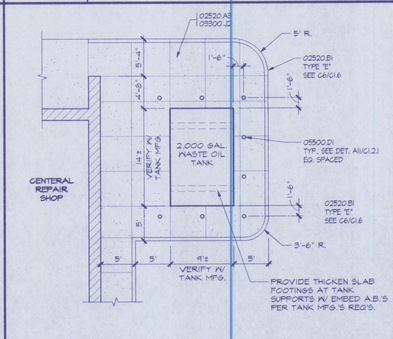

A1		
A4	DUMPSTER ENCLOSURE	⅛"=1'-0"
A7	ABOVE GROUND WASTE OIL TANK SLAB DETAIL	⅛"=1'-0"
A11	TYP. BOLLARD DETAIL	¾"=1'-0"

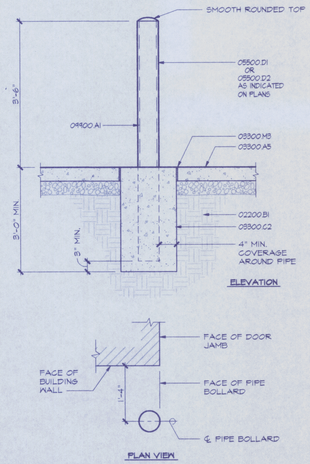

AS-BUILT

No.	REVISIONS & SUBMISSIONS	DATE
1		
2		
3		

Zeck|Butler ArchitectsPS
The Paulsen Center Suite 860 - West 421 Riverside, Spokane WA 99201 - (509) 456-8236/Fax (509) 747-0570
The Edwards Building - 1029 West Broadway, Moses Lake WA 98837 - (509) 765-8825/Fax (509) 765-8797

PROJECT TITLE
GRANT COUNTY PUBLIC WORKS OFFICE/SHOP COMPLEX
EPHRATA, WA.

SHEET TITLE
SITE DETAILS

SEAL
5974 REGISTERED ARCHITECT
KENT D. CHADWELL
STATE OF WASHINGTON

DATE	3/8/96
DRAWN	GTO
CHECKED	KDC
REVIEWED	KDC/WAP
PROJECT NO.	9513
DRAWING NO.	C1.2.1

F:\9513\9513C121 3-14-96 7:33:58 am EST